



BIM 360//WUSM NRBWUSM\_RB\_SPOOLING MASTER.rvt  
10/19/2021 12:21:21 PM

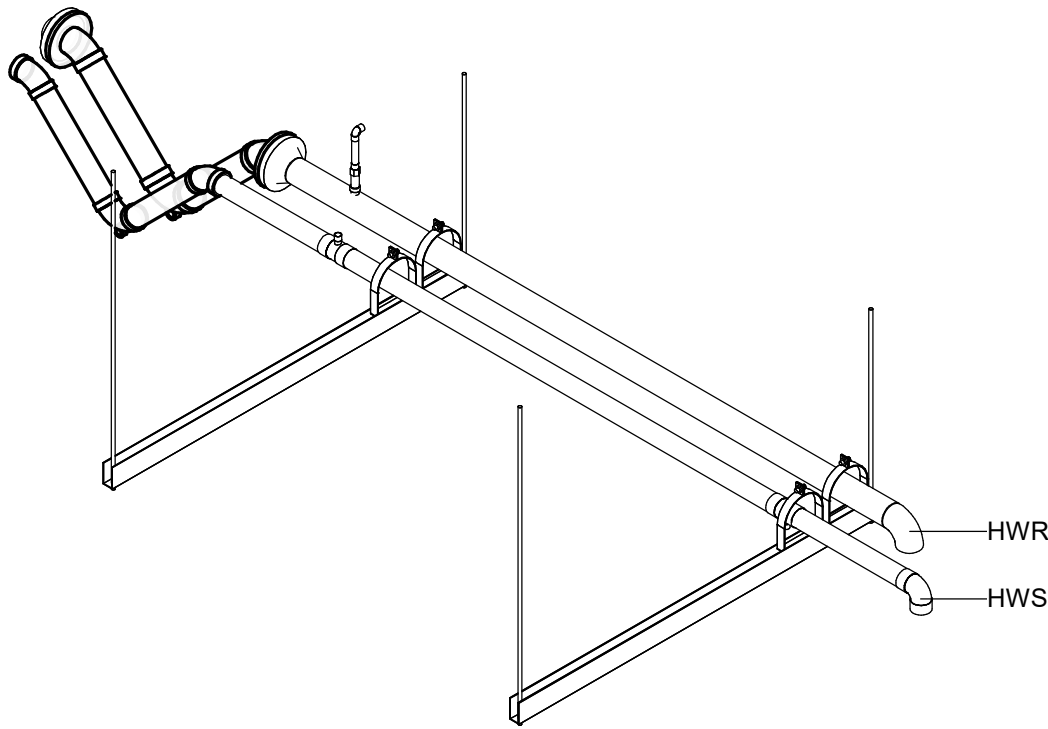


1 AS-L06-007 - ISOMETRIC  
AS-L06-007 SCALE:

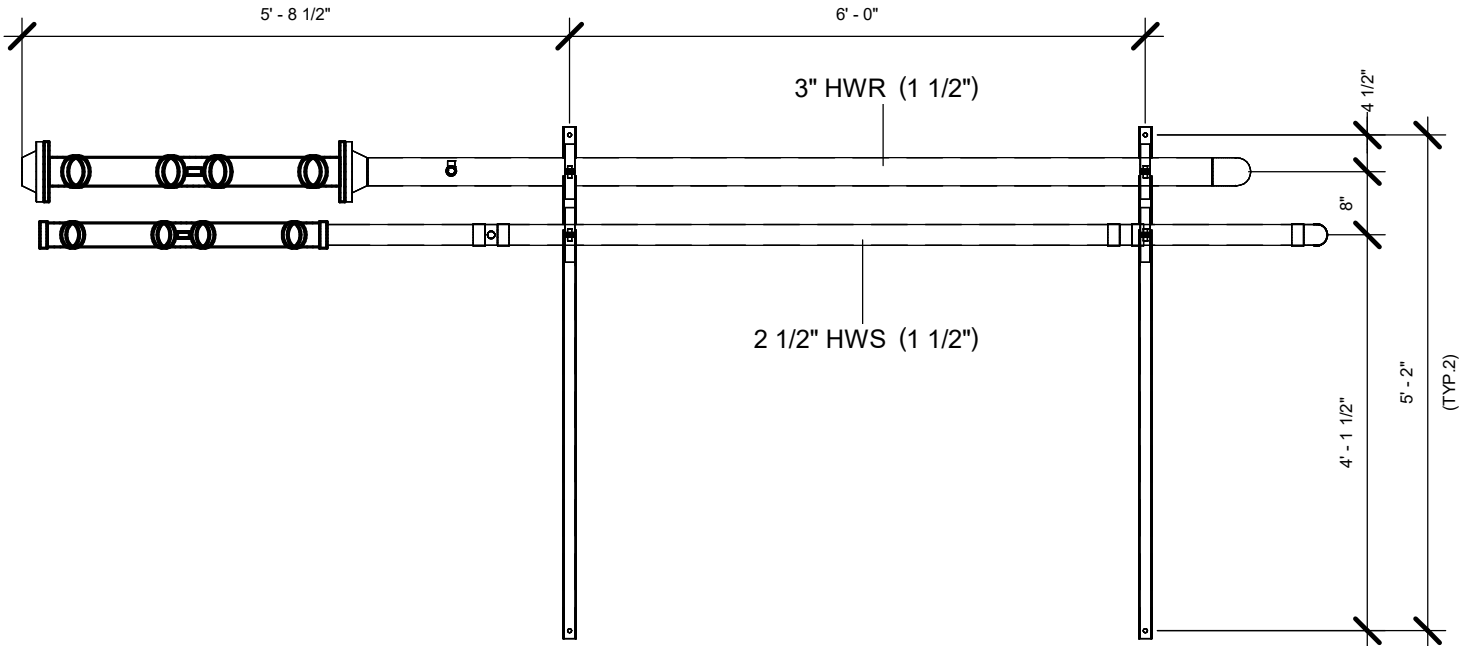

2 AS-L06-007  
AS-L06-007 SCALE: 1/2" = 1'-0"

A1	A3	B1	B3
A2	A4	B2	B4

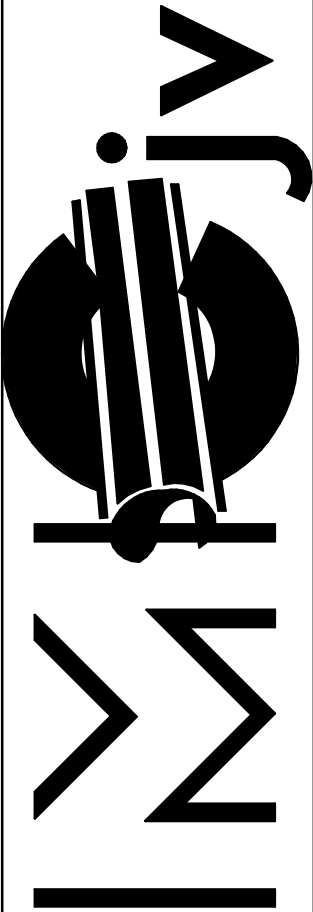

1233 N. Price Rd.  
St. Louis, Mo 63132-2303  
314-997-6600 phone

JOB: WASH U NRB


TICKET: AS-L06-007

Drawn By: Author


DATE: 10/08/21 DATE REQ:

BIM 360://WUSM NRBWUSM\_RB\_HPF.rvt  
10/25/2021 11:23:22 AM


Mark	Qty	Size	Description	Length	Strut Width	Rob 1	Rob 2	Insulation
<del>01</del>	<del>4</del>	<del>6"</del>	<del>B-Line B2000 ZN-Co. 40 Pipe Clamp</del>					
02	2	60"	B-Line 1-5/8 GRN 12GA Bk/Bk 2in Slotted Unistrut		5' - 4"	4' - 0 5/8"	2' - 8 5/8"	
01	2	6 5/8"	B-LINE #2020					
03	2	6 1/8"	B-LINE #2110					

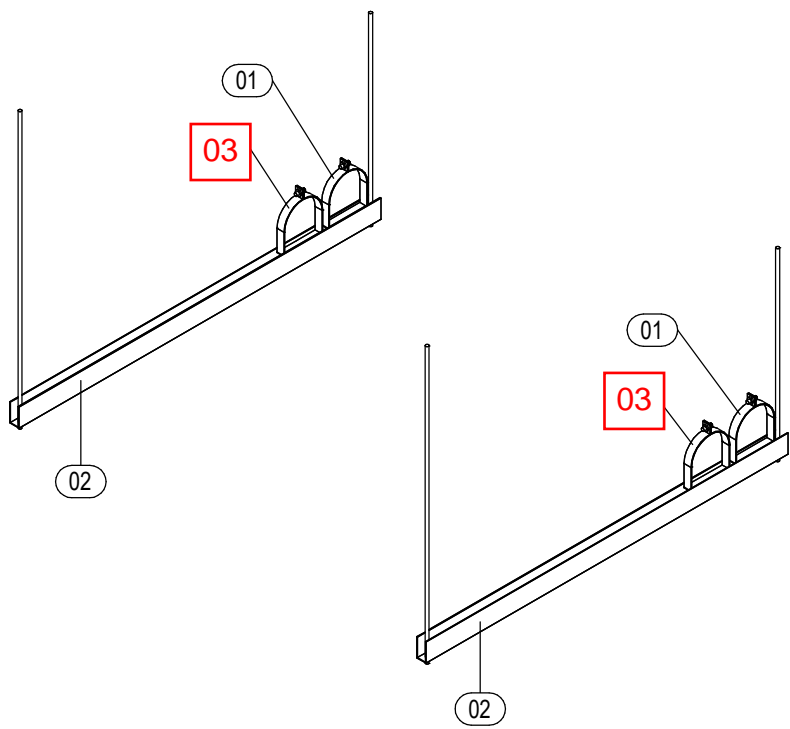

1 ISOMETRIC

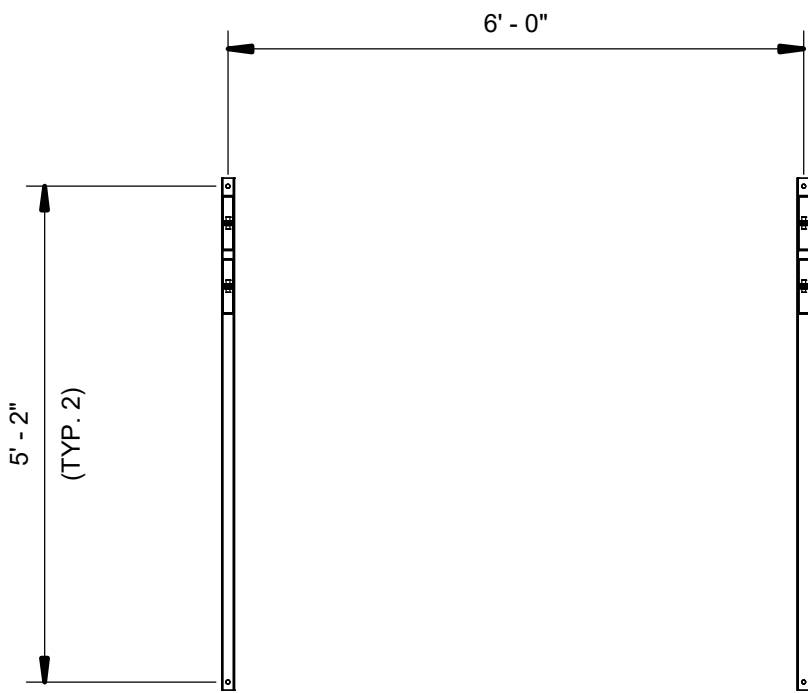


2 TOP VIEW

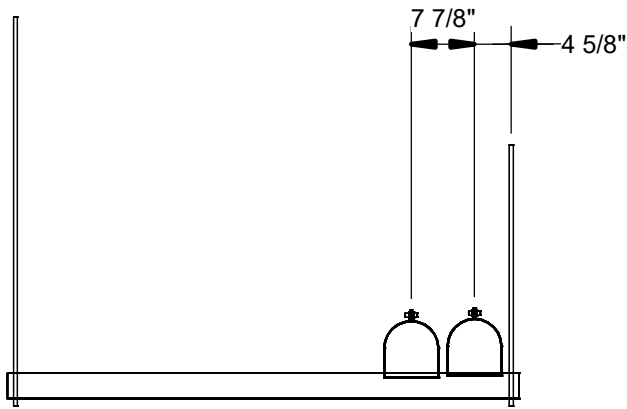

3 RIGHT ELEVATION

A1	A3	B1	B3
A2	A4	B2	B4


JOB:	WASH U NRB
TICKET:	HPHGR-L06-007
Drawn By: Author	
DATE: 10/08/21	DATE REQ:

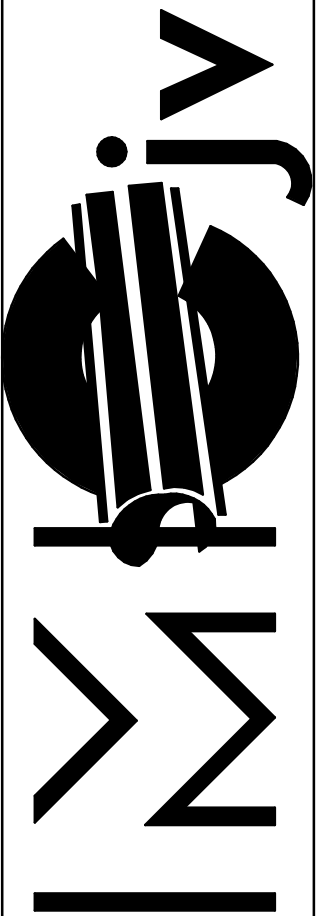

1233 N. Price Rd.  
St. Louis, Mo 63132-2303  
314-997-6600 phone


BIM 360://WUSM NRBWUSM\_RB\_HPF.rvt  
12/9/2021 10:22:28 AM

CONNECT TO:  
HWR-L06-006

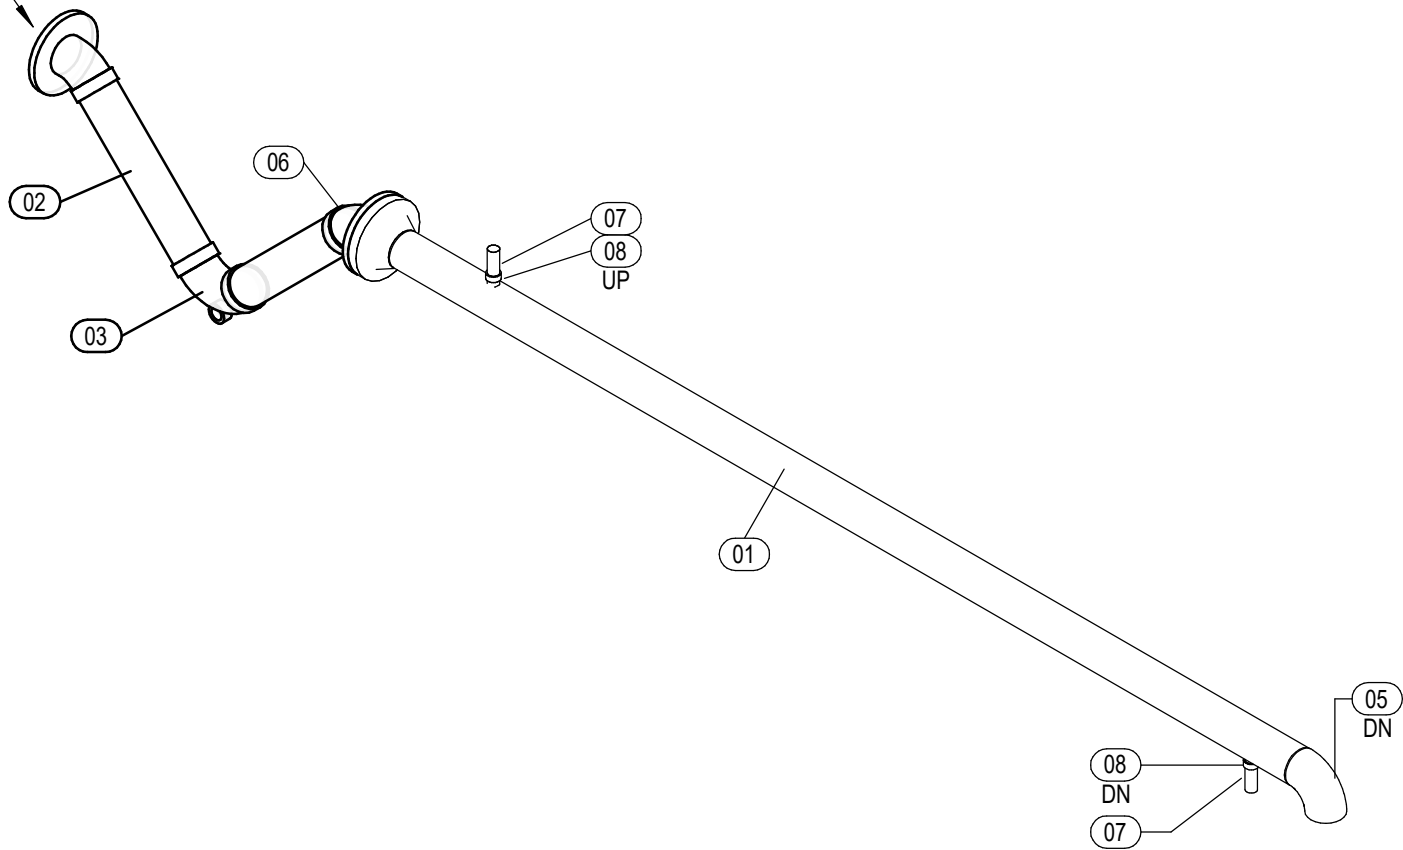

Mark	Qty	Description	Length	Size	Insulation
01	1	Chicago Area Sch 40 SA-53B CS ERW Pipe PE	8'-9 1/2"	3"	1 1/2"
02	1	V-Loop - Flanged Ends 3" Movement		3"	0"
03	1	Generic Elbow with Support Bracket and Sockets			0"
04	2	Generic Elbow with Socket and Flange			0"
05	1	Weldbend Std Wt SA234 WPB CS BW SR 90 Deg Ell		3"	1 1/2"
06	1	Weldbend 150lb RF Sch 40 Bore SA105 CS WN Flg		3"	1 1/2"
07	2	Victaulic No.647 TT Dielectric Transition Fitting		3/4"	1"
08	2	Anvil 3000# FS Thread-O-Let		3"x3/4"	1"

1 ISOMETRIC

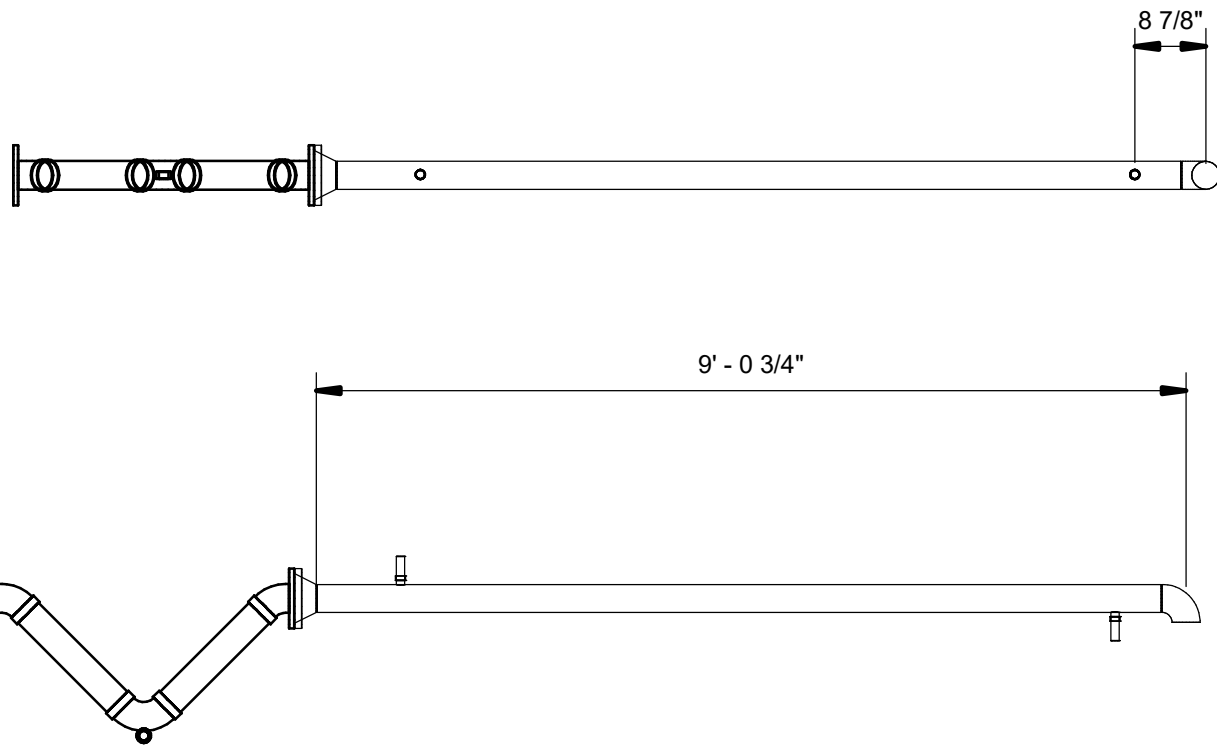

2 LEFT ELEVATION

A1	A3	B1	B3
A2	A4	B2	B4


JOB: WASH U NRB

TICKET: HWR-L06-007

Drawn By: Author

DATE: 10/08/21

DATE REQ:

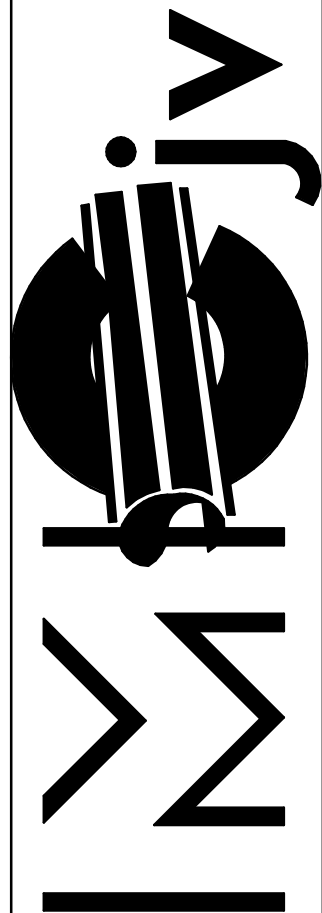


1233 N. Price Rd.  
St. Louis, Mo 63132-2303  
314-997-6600 phone


BIM 360//WUSM NRBWUSM\_RB\_HPF.rvt  
10/21/2021 1:12:52 PM

Mark	Qty	Size	Description	Length	Strut Width	Rob 1	Rob 2	Insulation
01	1	2 1/2"	Cerro Type K Hard Copper Pipe	6'-5 13/16"				1 1/2"
02	1	2 1/2"	Cerro Type K Hard Copper Pipe	1'-9 7/16"				1 1/2"
03	1	2 1/2"	Cerro Type K Hard Copper Pipe	1'-7 3/4"				1 1/2"
04	1	2 1/2"	V-Loop - Sweat Ends 3" Movement					0"
05	1		Generic Elbow with Support Bracket and Sockets					0"
06	2		Generic Elbow with Sockets					0"
07	1	2 1/2"x3/4"x2 1/2"	Nibco Wrot 611R CxCxC Reducing Tee					1 1/2"
08	1	2 1/2"x3/4"	Nibco Wrot 611R CxCxC Reducing Tee					1 1/2"
09	1	2 1/2"	Nibco Wrot 607 90 Deg Ell CxC					1 1/2"
10	1	3/4"	Generic Solder Joint					1"
11	2	2 1/2"	Generic Solder Joint					1 1/2"

CONNECT TO:  
AS-L06-006

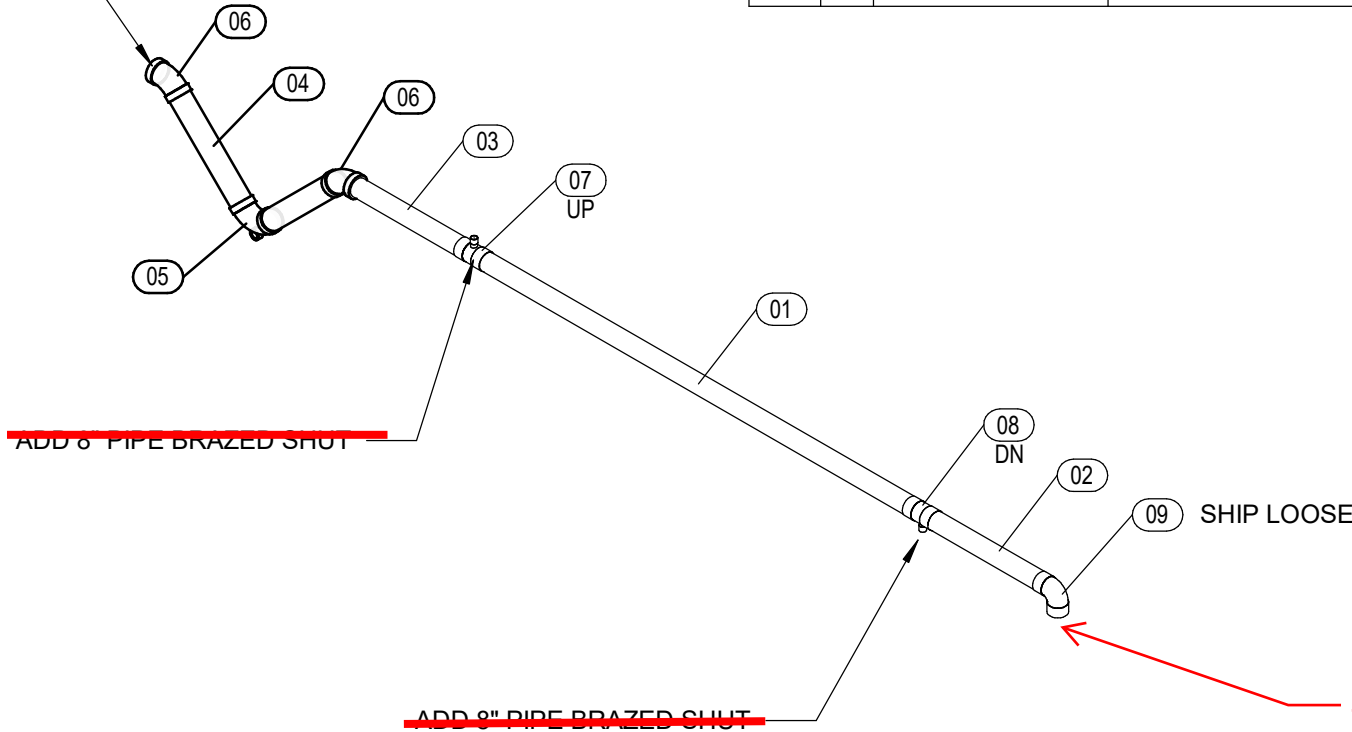


1 ISOMETRIC

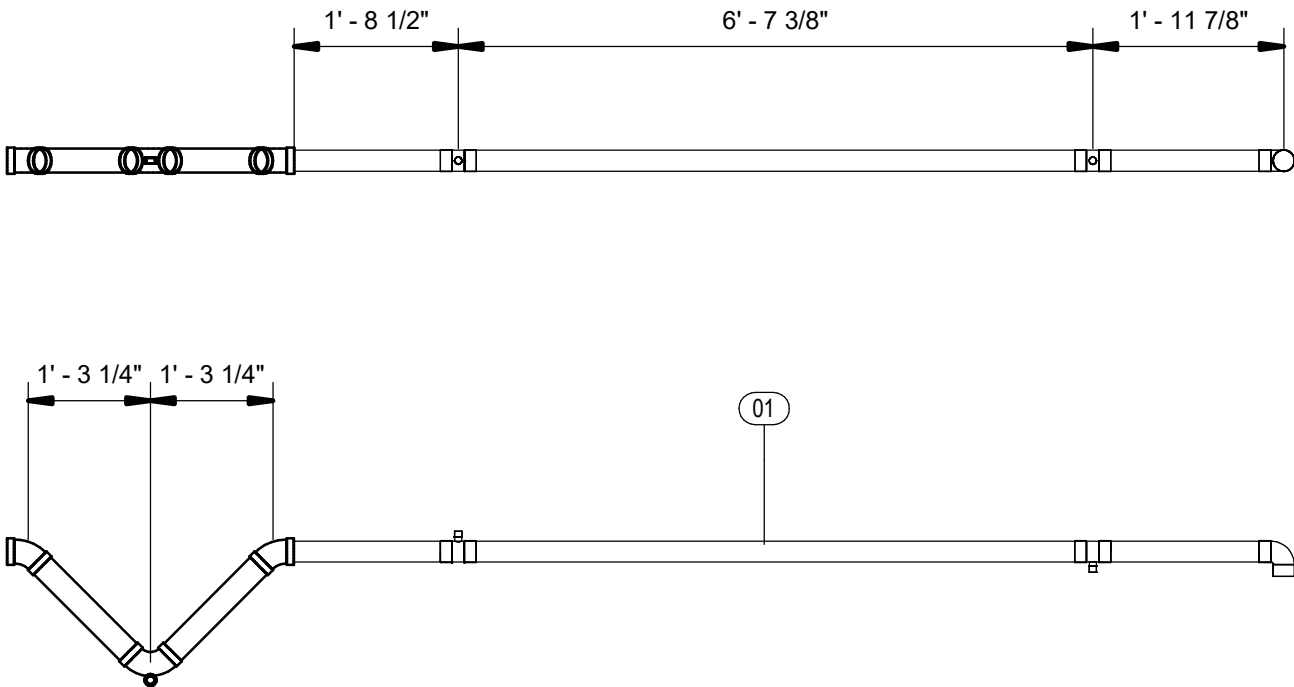

3 LEFT ELEVATION  
SCALE: 1/2" = 1'-0"

A1	A3	B1	B3
A2	A4	B2	B4

JOB: WASH U NRB  
TICKET: HWS-L06-007  
Drawn By: Author  
DATE: 10/08/21

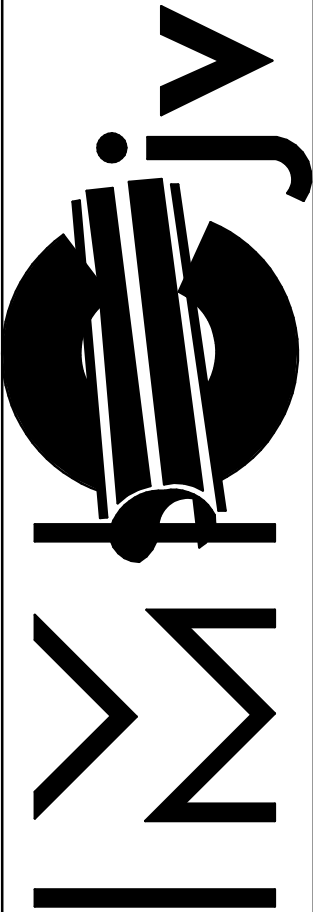

1233 N. Price Rd.  
St. Louis, Mo 63132-2303  
314-997-6600 phone