



BIM 360//WUSM NRBWUSM\_RB\_SPOOLING MASTER.rvt  
12/16/2021 1:31:51 PM

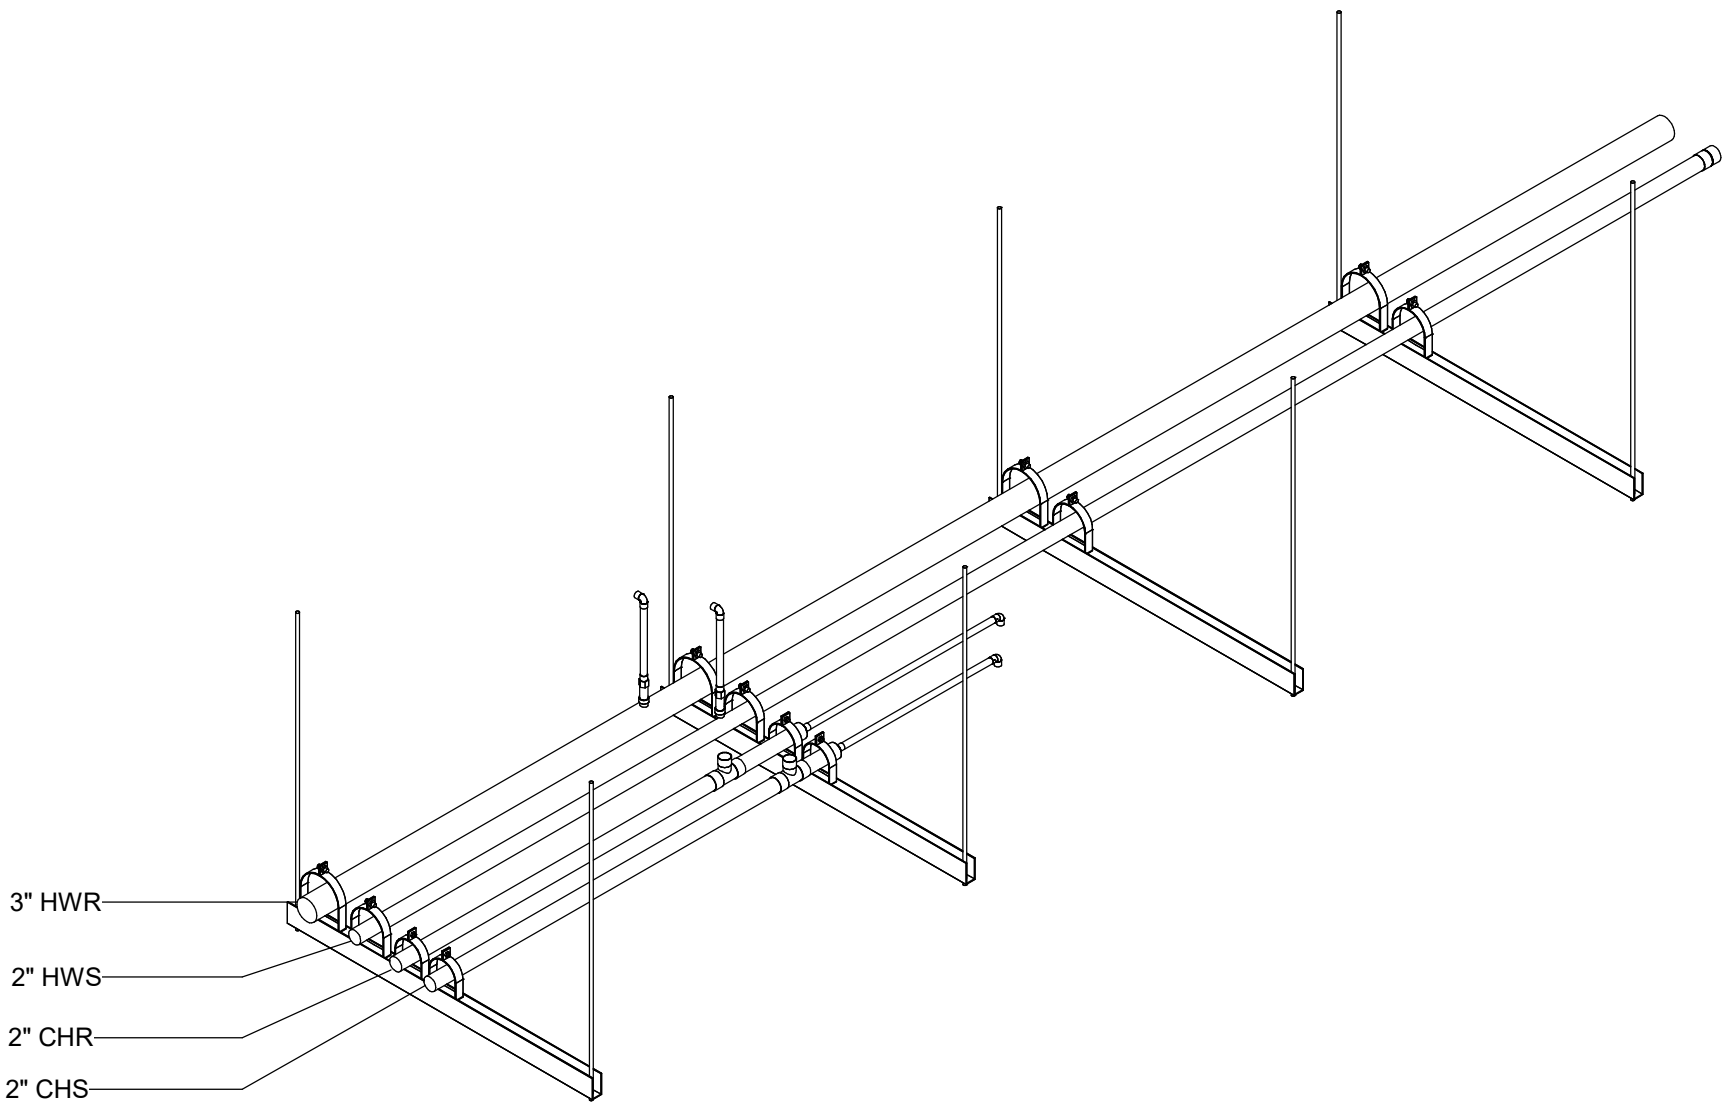

1 AS-L07-050 - ISOMETRIC  
AS-L07-050 SCALE:

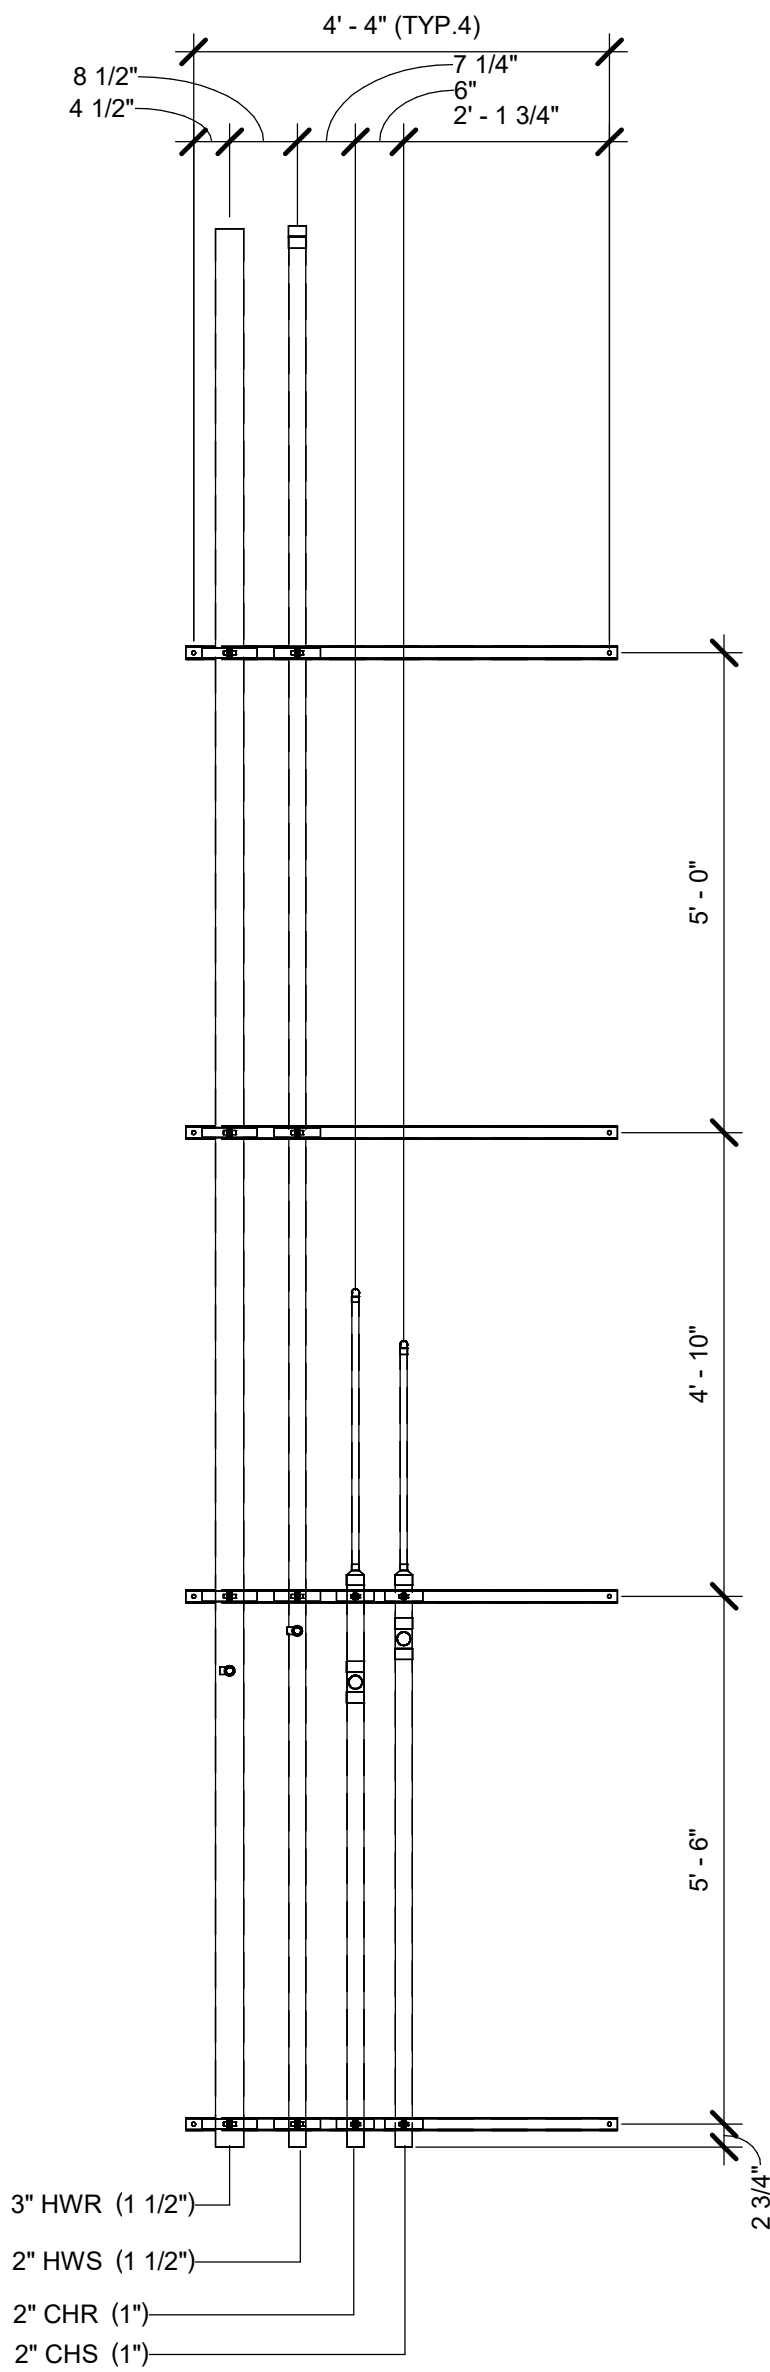

2 AS-L07-050  
AS-L07-050 SCALE: 1/2" = 1'-0"

A1	A3	B1	B3
A2	A4	B2	B4



1233 N. Price Rd.  
St. Louis, Mo 63132-2303  
314-997-6600 phone

JOB: WASH U NRB

TICKET: AS-L07-050


Drawn By: Author

DATE: 11/24/21 DATE REQ:


BIM 360//WUSM NRBWUSM\_RB\_HPF.rvt  
17-11-2021 17:00:06

Mark	Qty	Size	Description	Length	Strut Width	Rob 1	Rob 2	Insulation
01	4	6"	<del>B-Line B2000 ZN Sch 40 Pipe Clamp</del>		0"		0"	
02	4	5"	<del>B-Line B2000 ZN Sch 40 Pipe Clamp</del>		0"		0"	
03	4	4"	<del>B-Line B2000 ZN Sch 40 Pipe Clamp</del>		0"		0"	
04	4	50"	B-Line 1-5/8 GLV 12GA Bk/Bk 2in Slotted Unistrut		4' - 6"	4' - 0 5/8"	4' - 0 5/8"	

01	4	6 5/8"	B Line #2020
02	4	5 1/8"	B Line #2062
03	4	4 1/8"	B Line #2054

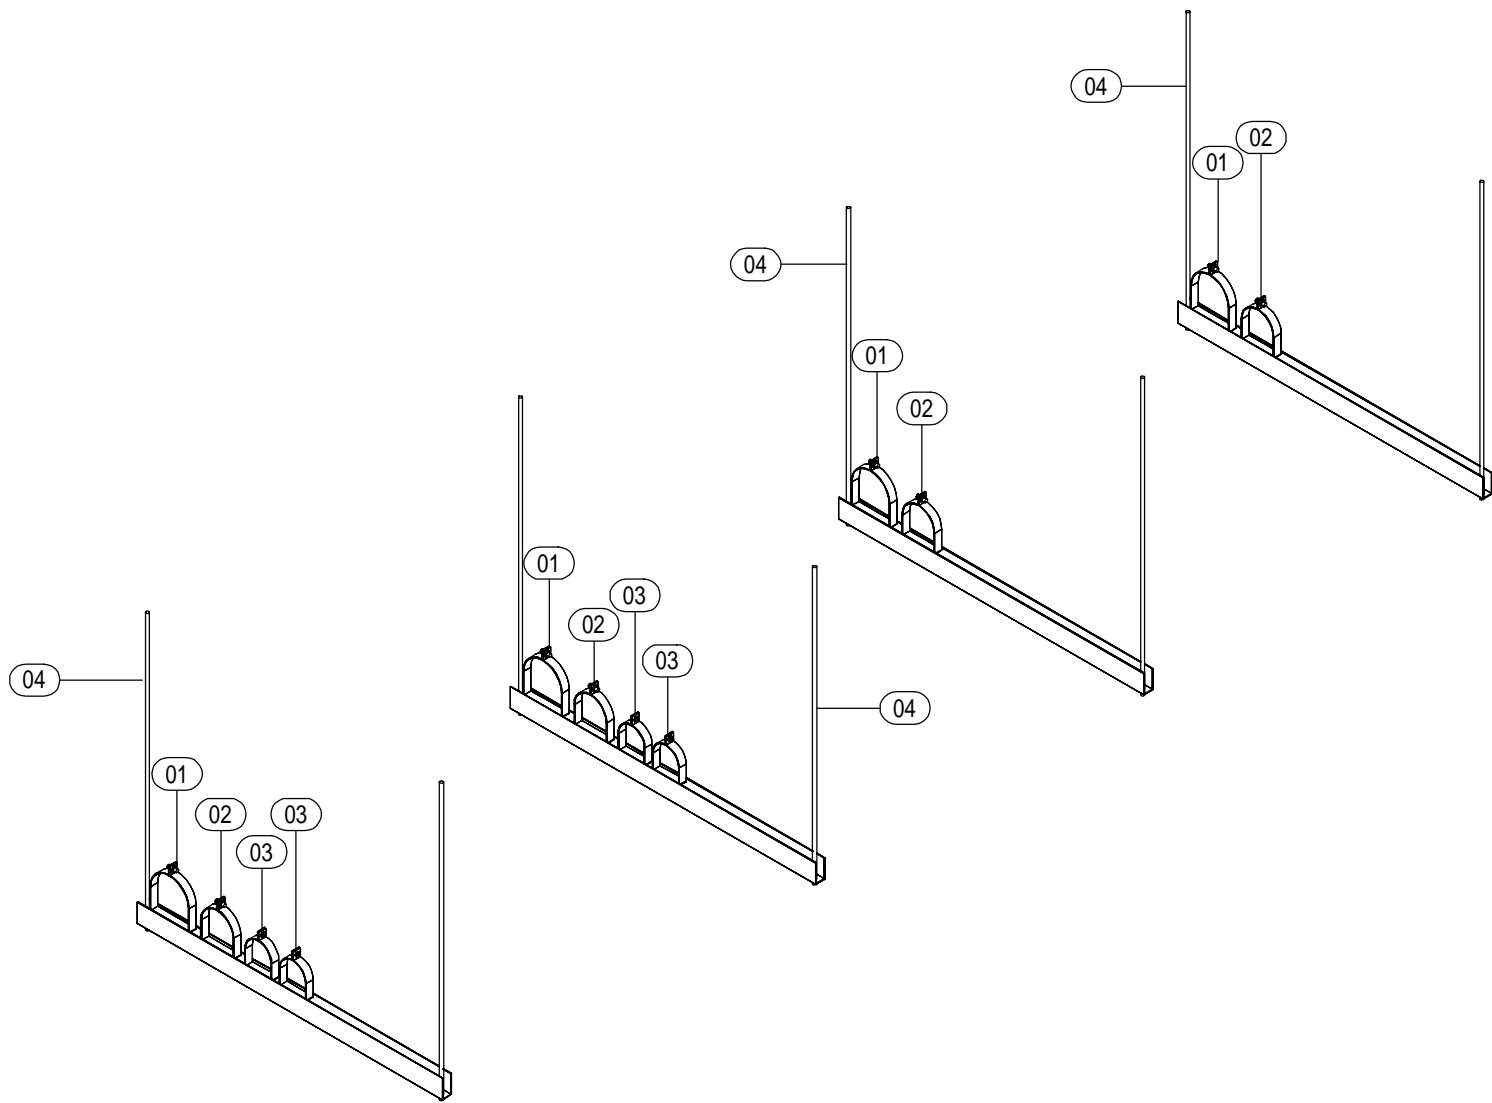


1 ISOMETRIC  
SCALE:

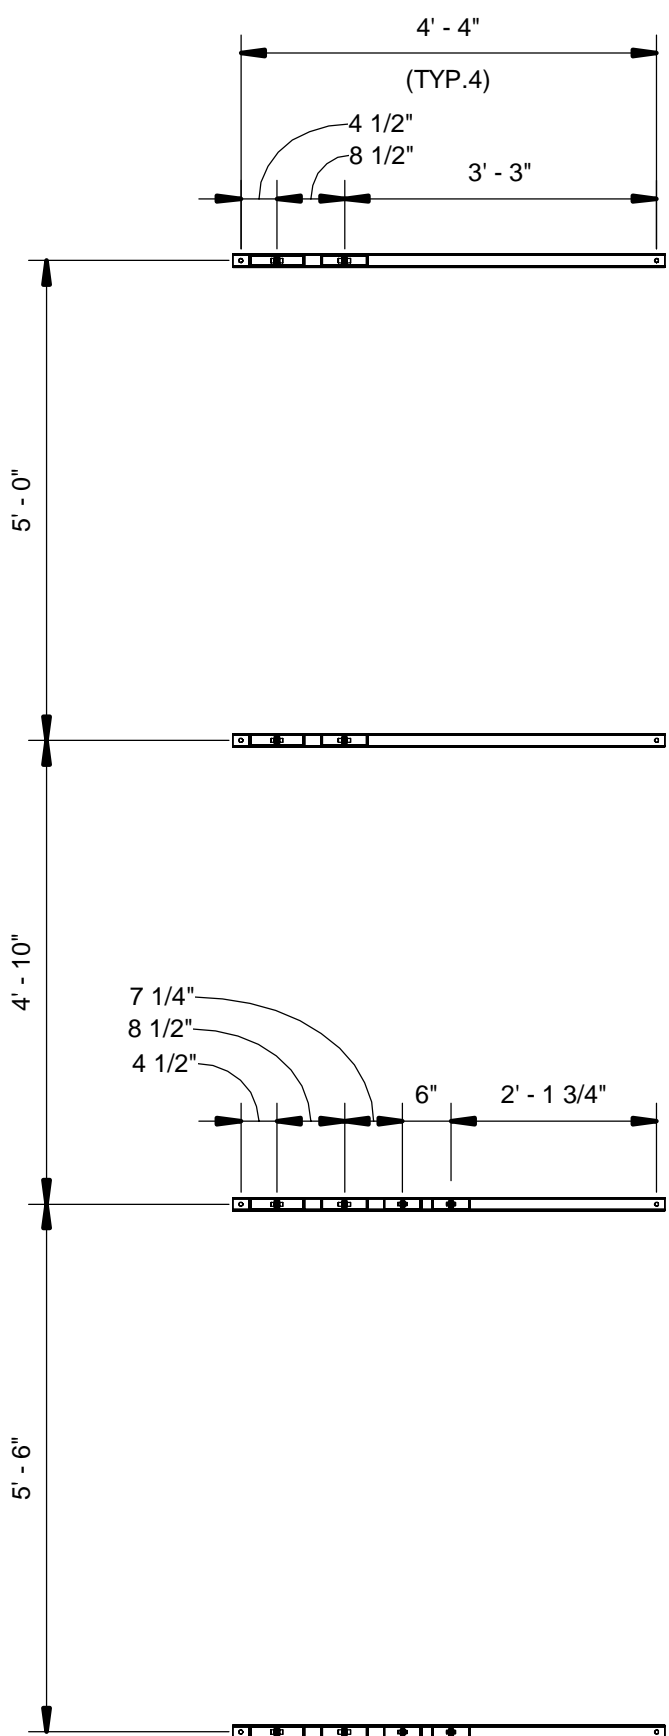

2 TOP VIEW  
SCALE: 1/2" = 1'-0"

A1	A3	B1	B3
A2	A4	B2	B4


JOB:	WASH U NRB
TICKET:	HPHGR-L07-050
Drawn By:	Author
DATE:	11/17/21
DATE REQ:	

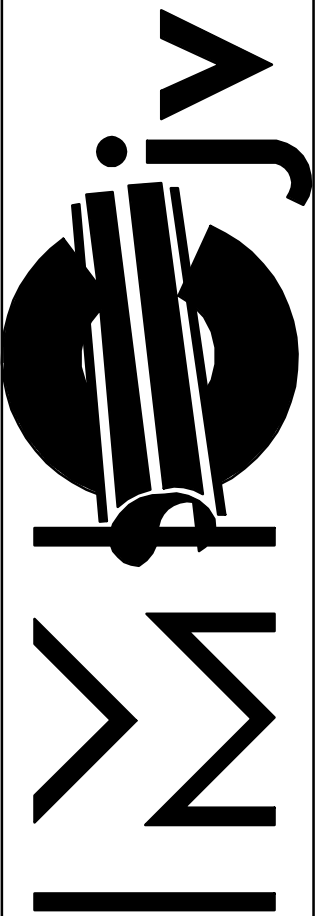


1233 N. Price Rd.  
St. Louis, Mo 63132-2303  
314-997-6600 phone

BIM 360://WUSM NRBWUSM\_RB\_HPF.rvt  
17-11-2021 16:34:00

Mark	Qty	Size	Description	Length	Strut Width	Rob 1	Rob 2	Insulation
01	1	2"	Cerro Type K Hard Copper Pipe	4'-8 7/8"				1"
02	1	3/4"	Cerro Type K Hard Copper Pipe	2'-10 1/4"				1"
03	1	2"	Cerro Type K Hard Copper Pipe	1'-0 3/16"				1"
04	1	2"x1 1/2"	Nibco Wrot 611R CxCxC Reducing Tee					1"
05	1	3/4"	Nibco Wrot 607 90 Deg Ell CxC					1"
06	1	2"x3/4"	Nibco Wrot 600R Red Cplg CxC					1"

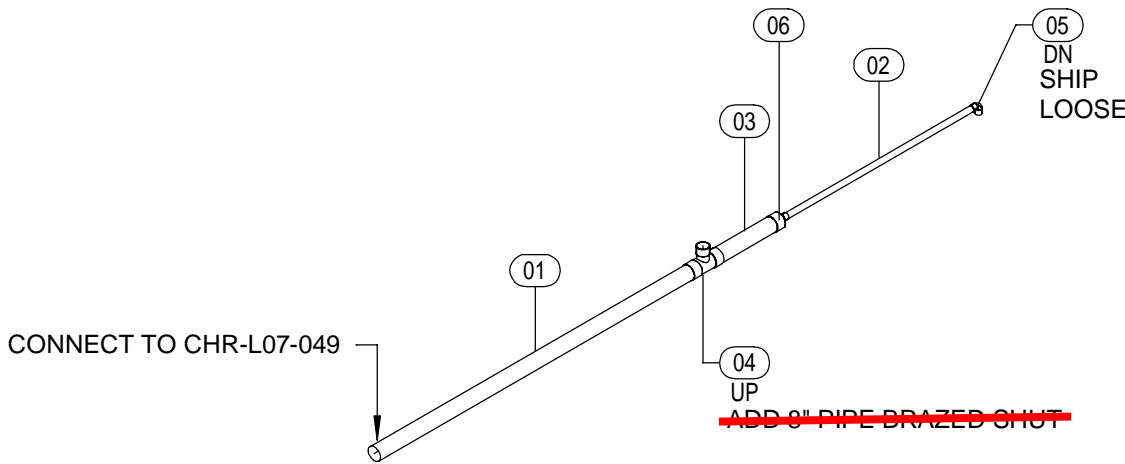


1 ISOMETRIC  
SCALE:

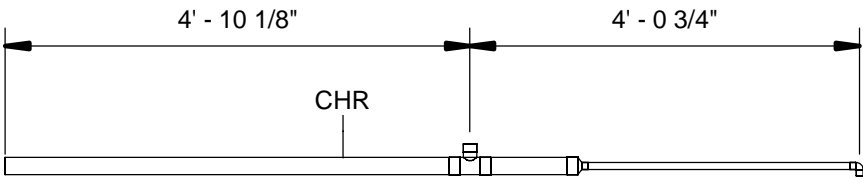

2 RIGHT ELEVATION  
SCALE: 1/2" = 1'-0"

A1	A3	B1	B3
A2	A4	B2	B4

JOB: WASH U NRB  
TICKET: CHR-L07-050  
Drawn By: Author  
DATE: 11/17/21  
DATE REQ:

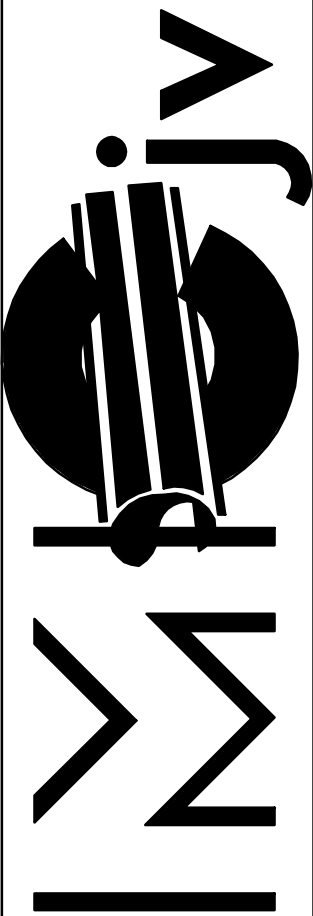

1233 N. Price Rd.  
St. Louis, Mo 63132-2303  
314-997-6600 phone


1233 N. Price Rd.  
St. Louis, Mo 63132-2303  
314-997-6600 phone

Mark	Qty	Size	Description	Length	Strut Width	Rob 1	Rob 2	Insulation
01	1	2"	Cerro Type K Hard Copper Pipe	5'-2 5/16"				1"
02	1	2"	Cerro Type K Hard Copper Pipe	0'-6 3/4"				1"
03	1	3/4"	Cerro Type K Hard Copper Pipe	2'-3 3/4"				1"
04	1	2"x1 1/2"	Nibco Wrot 611R CxCxC Reducing Tee					1"
05	1	3/4"	Nibco Wrot 607 90 Deg Ell CxC					1"
06	1	2"x3/4"	Nibco Wrot 600R Red Cplg CxC					1"

DATE: 11/17/21	DATE REQ:
----------------	-----------


BIM 360://WUSM NRBWUSM\_RB\_HPF.rvt  
2/1/2022 11:42:40 AM

Mark	Qty	Size	Description	Length	Insulation
01	1	3"	Chicago Area Sch 40 SA-53B CS ERW Pipe PE	19'-11 7/8"	1 1/2"
02	1	3/4"	Victaulic No.647 TT Dielectric Transition Fitting		1"
03	1	3"x3/4"	Anvil 3000# FS Thread-O-Let		1"

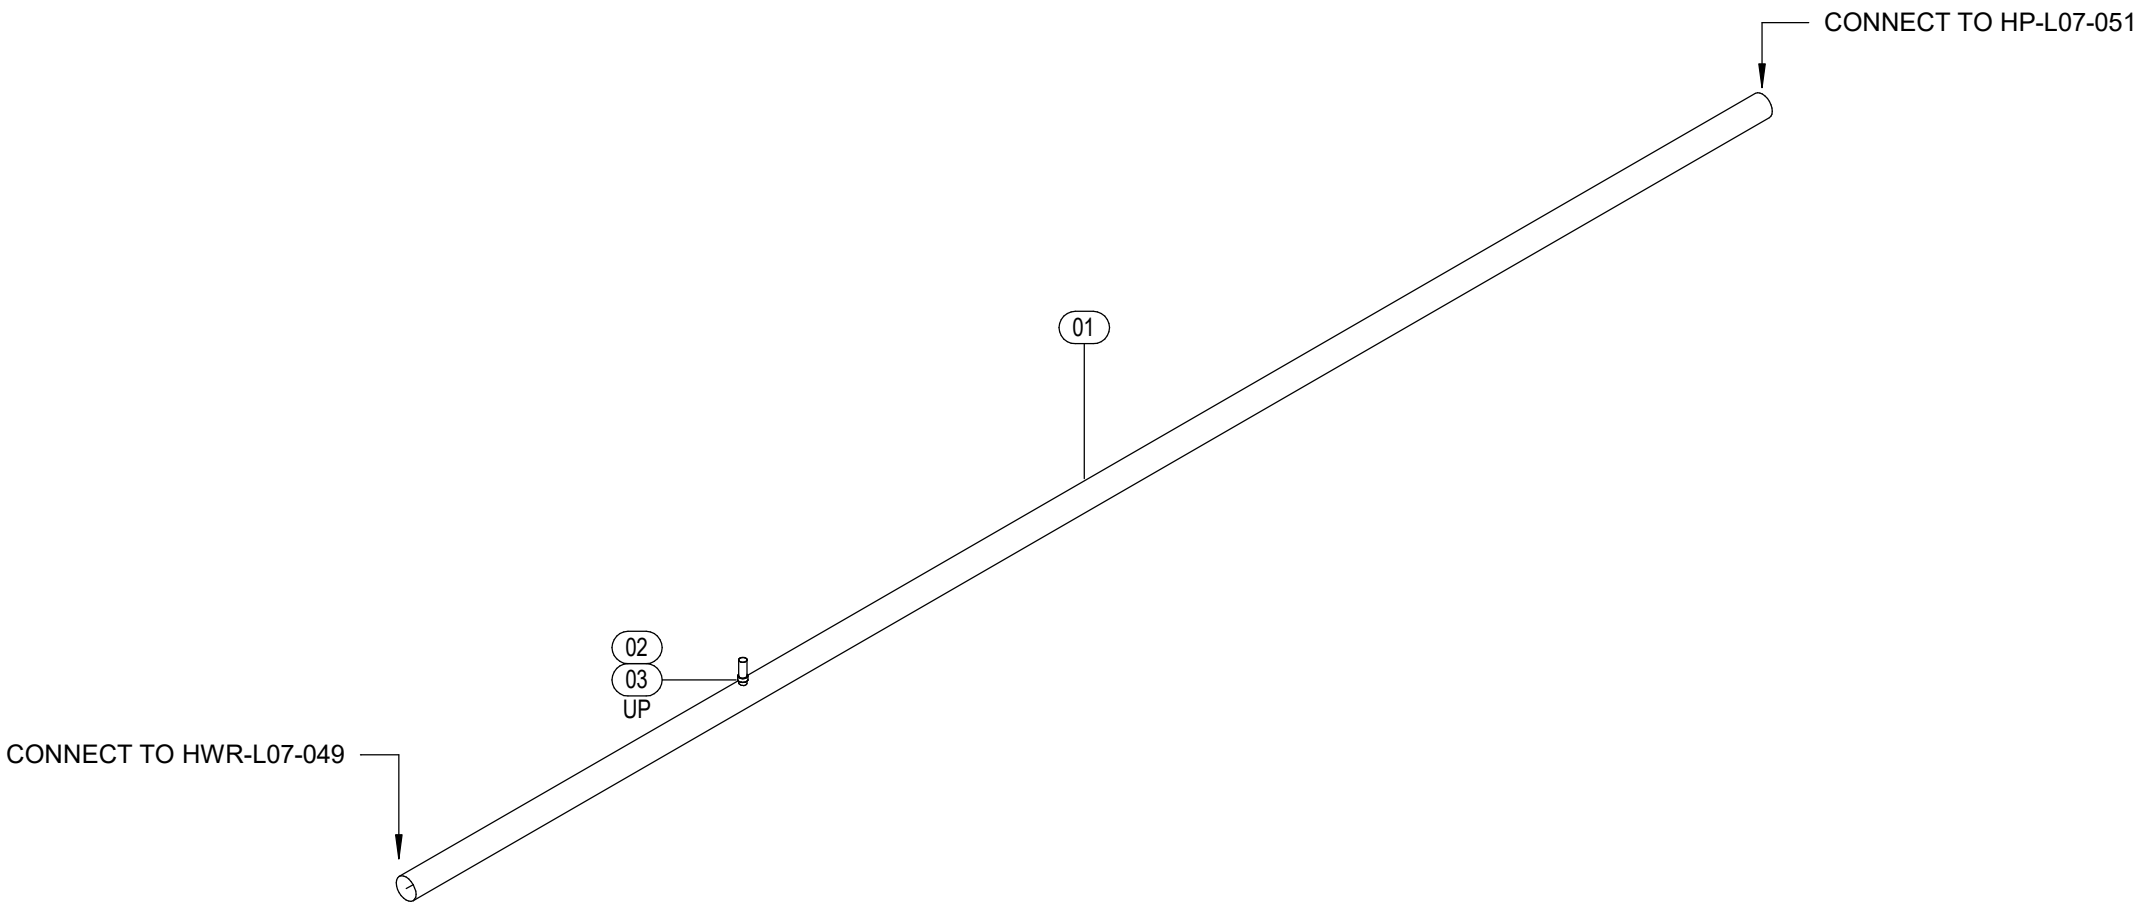

1 ISOMETRIC

SCALE:

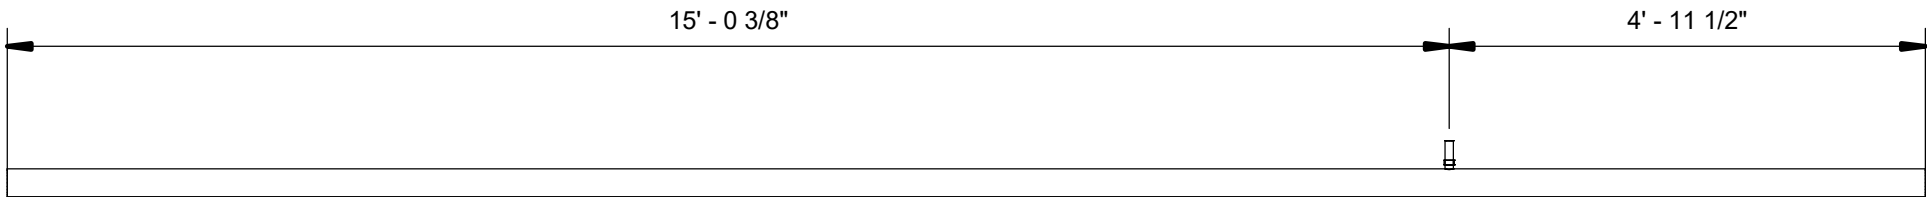


2 LEFT ELEVATION

SCALE: 1/2" = 1'-0"

A1	A3	B1	B3
A2	A4	B2	B4


JOB:	210140 - WASH U NRB
TICKET:	HWR-L07-050
Drawn By: Author	
DATE: 11/17/21	DATE REQ:

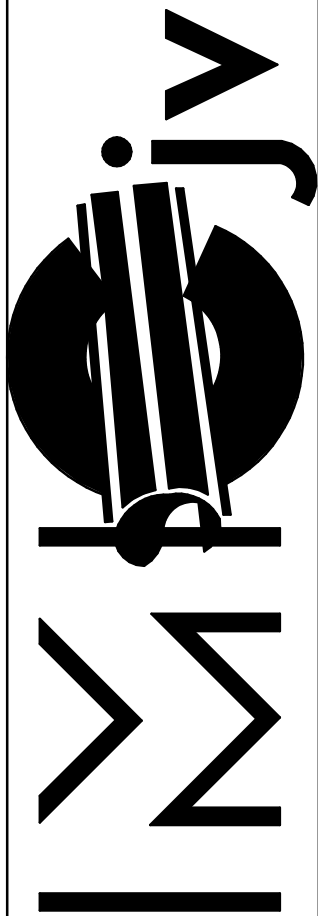

1233 N. Price Rd.  
St. Louis, Mo 63132-2303  
314-997-6600 phone


BIM 360://WUSM NRBWUSM\_RB\_HPF.rvt  
2/1/2022 11:42:44 AM

Mark	Qty	Size	Description	Length	Insulation
01	1	2"	Cerro Type K Hard Copper Pipe	5'-4"	1 1/2"
02	1	2"	Cerro Type K Hard Copper Pipe	14'-5 7/8"	1 1/2"
03	1	2"x3/4"	Nibco Wrot 611R CxCxC Reducing Tee		1 1/2"
04	1	2"	Nibco Wrot 600 Dimpled Stop Coupling CxC		1 1/2"

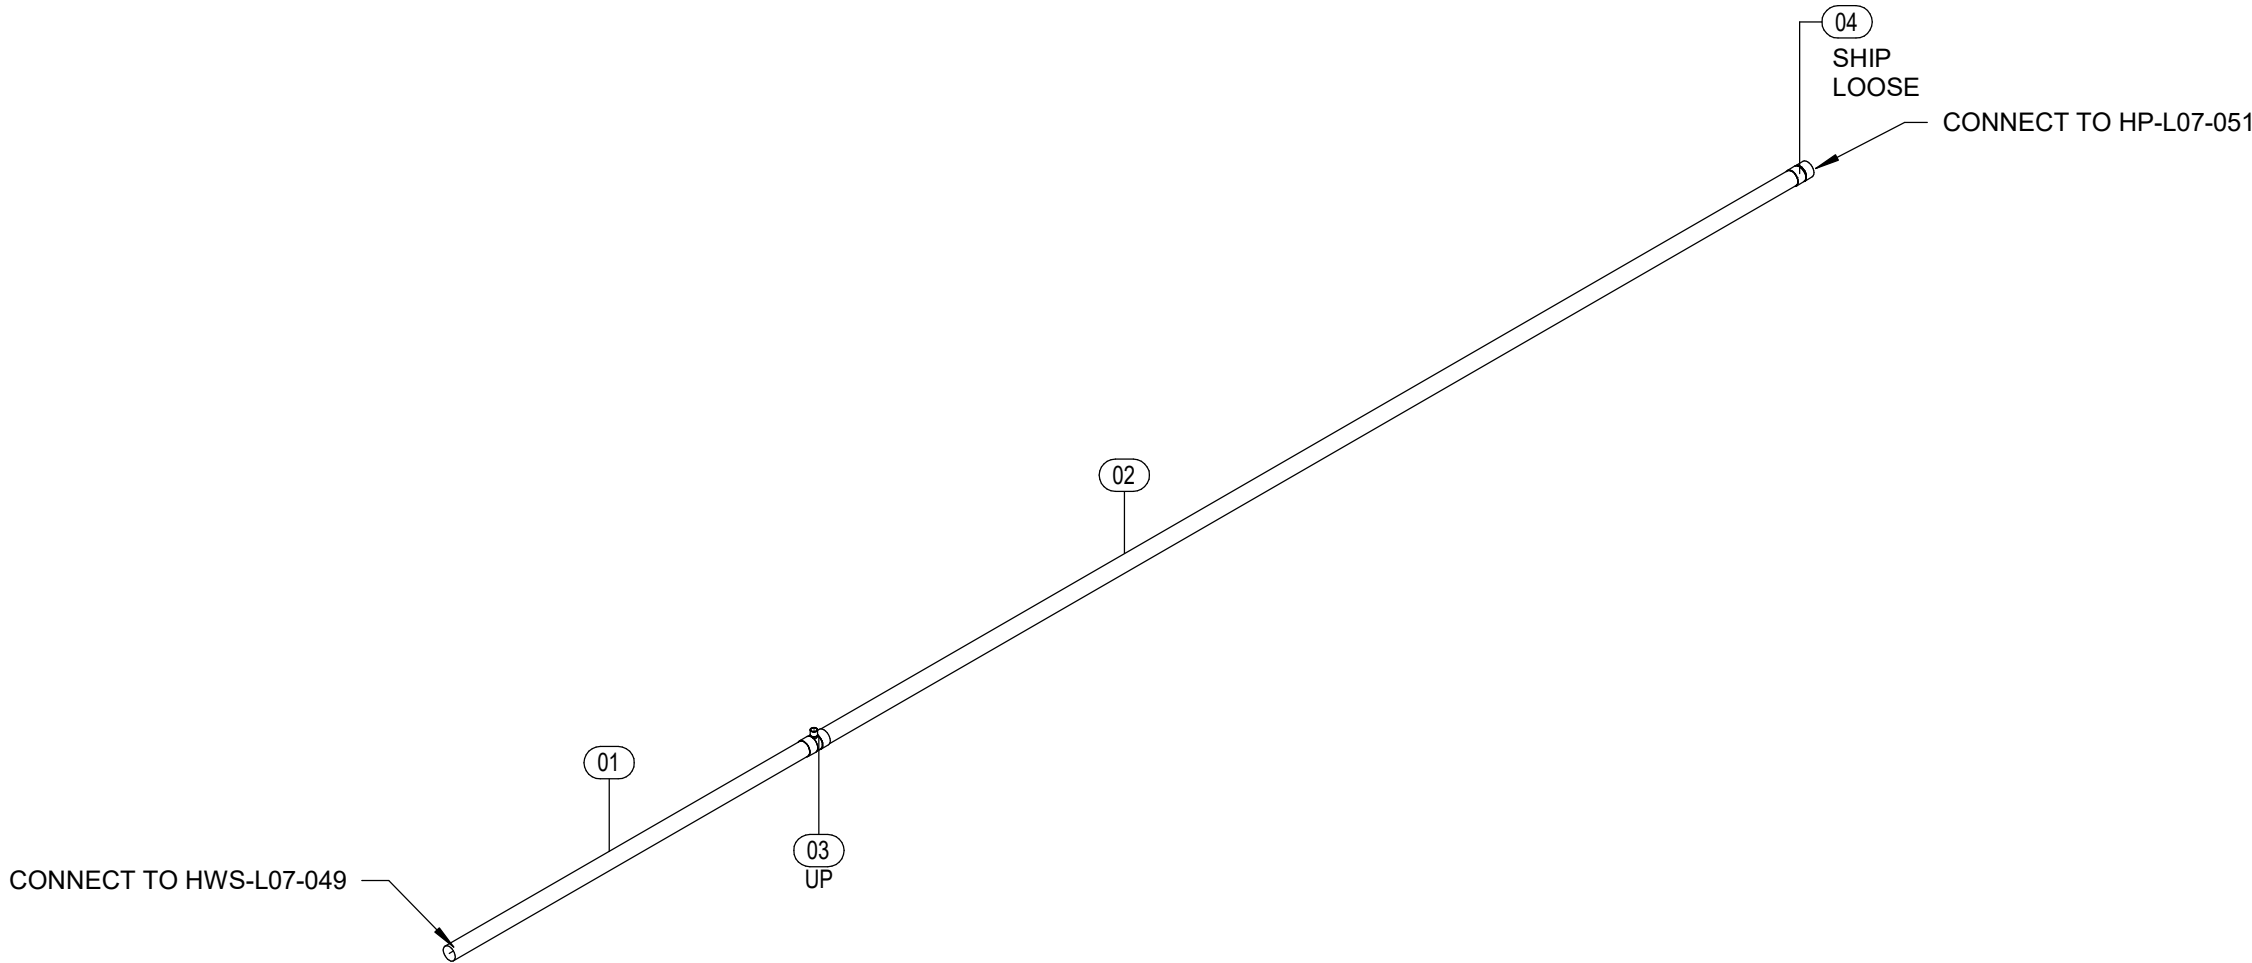

1 ISOMETRIC

SCALE:

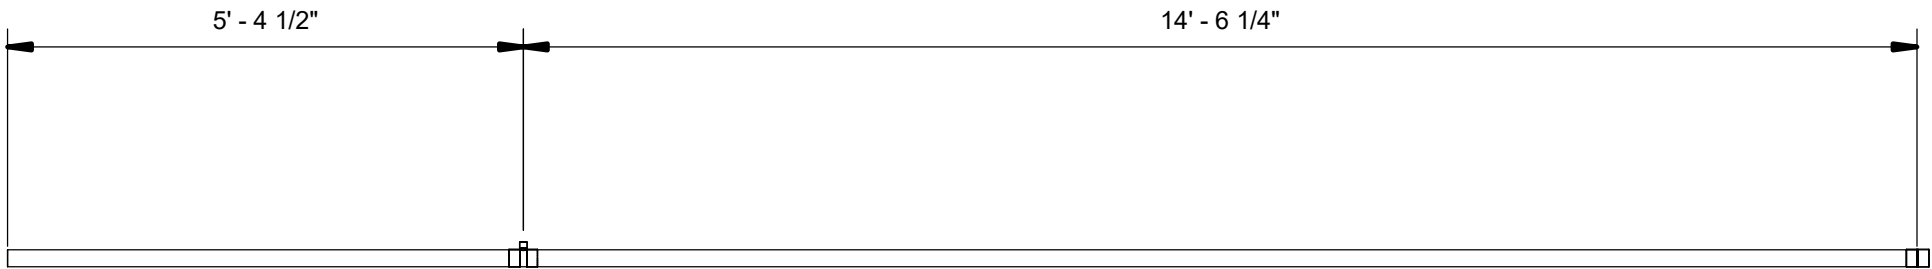


3 RIGHT ELEVATION

SCALE: 1/2" = 1'-0"

A1	A3	B1	B3
A2	A4	B2	B4

JOB: 210140 - WASH U NRB  
TICKET: HWS-L07-050  
Drawn By: Author  
DATE: 11/17/21 DATE REQ:

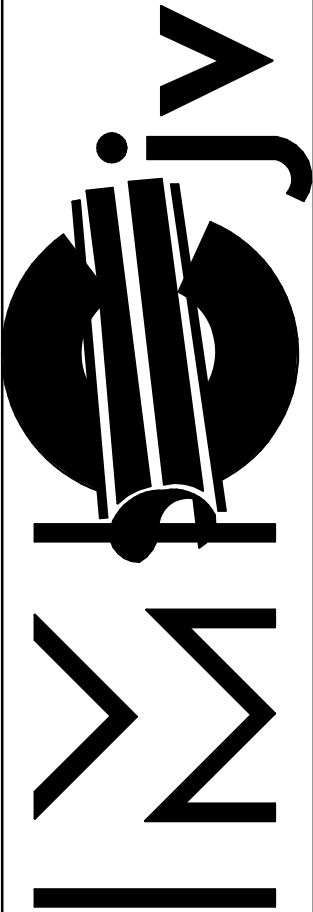

1233 N. Price Rd.  
St. Louis, Mo 63132-2303  
314-997-6600 phone