



BIM 360//WUSM NRBWUSM\_RB\_SPOOLING MASTER.rvt  
8/30/2021 9:52:33 AM

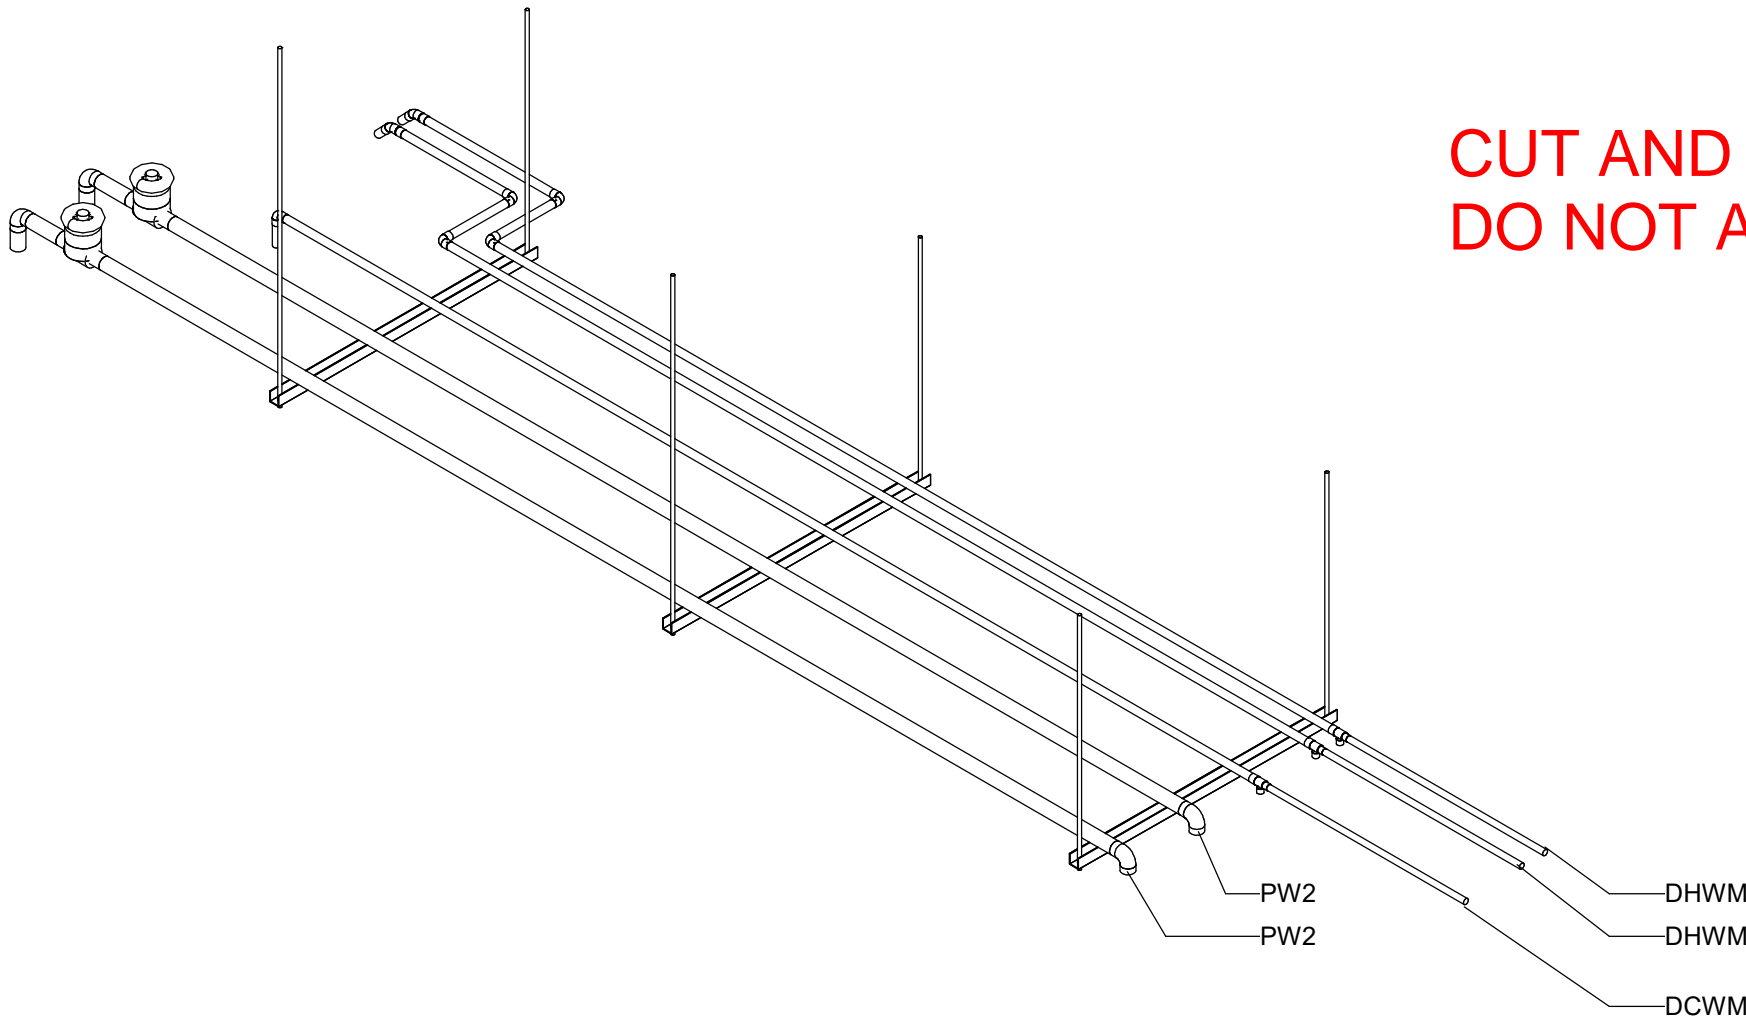

CUT AND PACKAGE ONLY  
DO NOT ASSEMBLE


2 AS-L03-070 - ISOMETRIC  
AS-L03-070 SCALE:

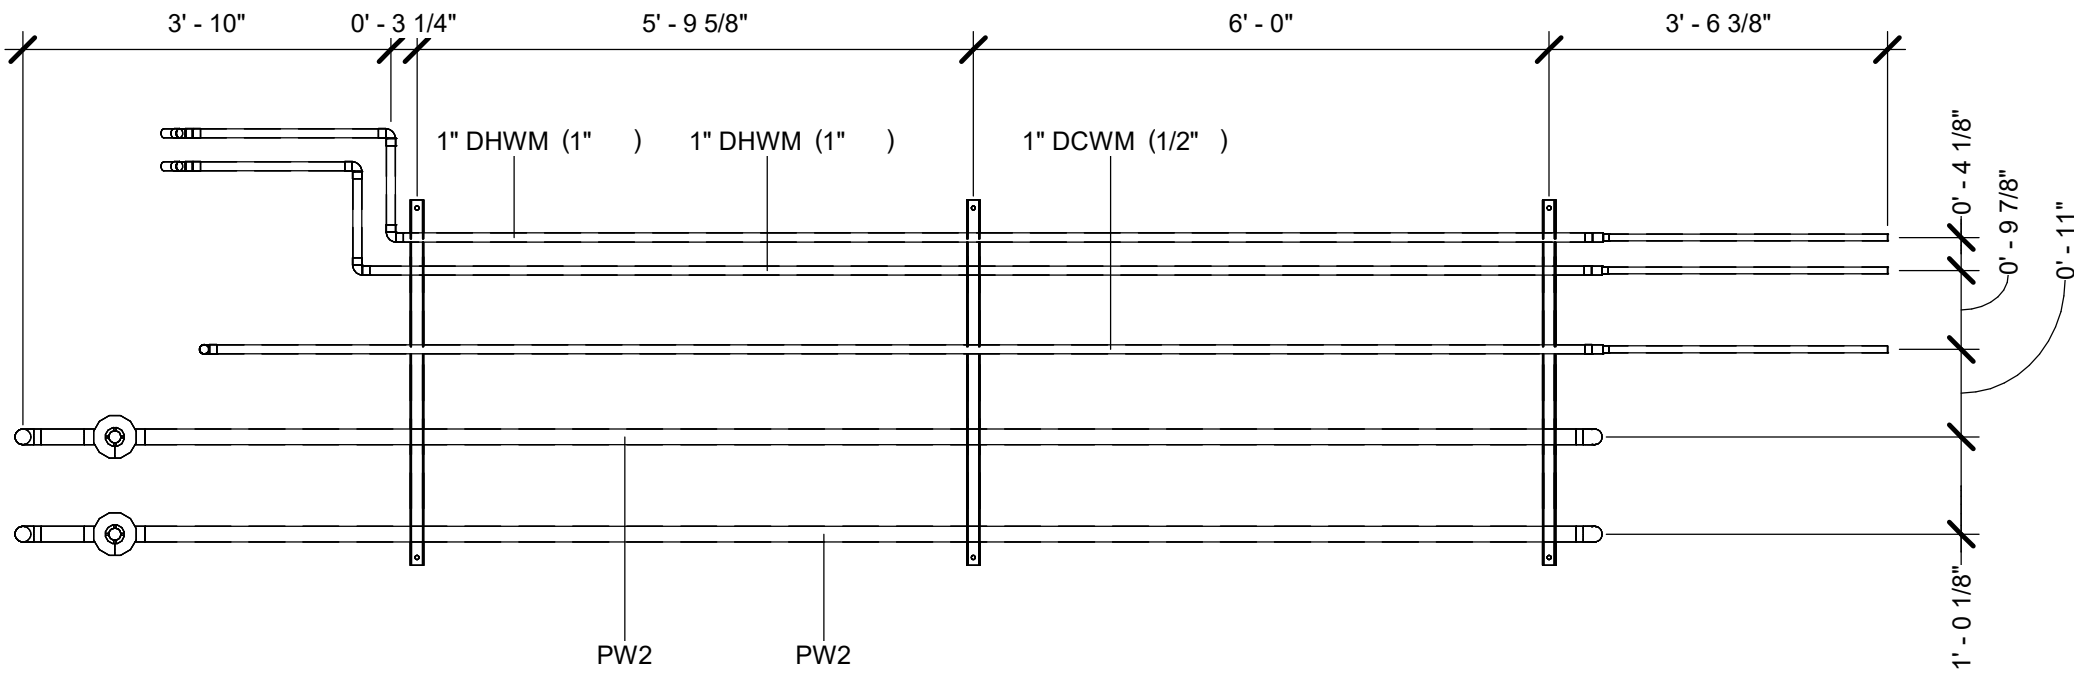

1 AS-L03-070  
AS-L03-070 SCALE: 1/2" = 1'-0"

A1	A3	B1	B3
A2	A4	B2	B4




JOB:	WASH U NRB
TICKET:	AS-L03-070
Drawn By: Author	
DATE: 08/09/21	DATE REQ:

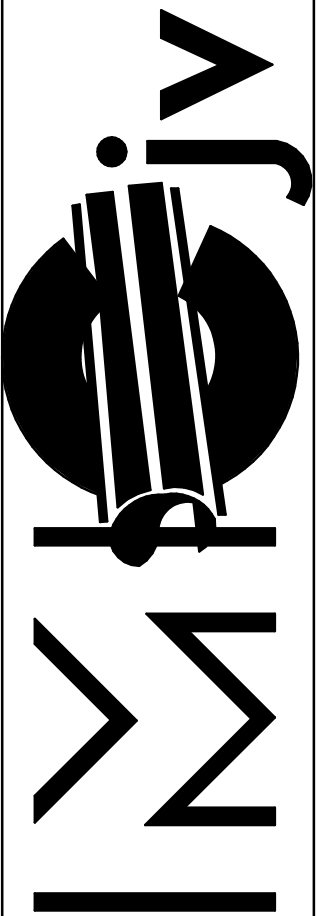

1233 N. Price Rd.  
St. Louis, Mo 63132-2303  
314-997-6600 phone



BIM 360://WUSM NRBWUSM\_RB\_PLF.rvt  
8/31/2021 10:08:54 AM

Mark	Qty	Size	Description	Length	Strut Width	Rod 1	Rod 2	Insulation
<del>01</del>	<del>6</del>	<del>3</del>	<del>B-Line B2000 ZN Sch 40 Pipe Clamp</del>					
02	2	24"	B-Line 1-5/8 GLV 12GA 2in Slotted Unistrut		2'-4"	4'-7"	3'-3"	
<del>03</del>	<del>3</del>	<del>3"</del>	<del>B-Line B2000 ZN Sch 40 Pipe Clamp</del>					
04	1	18"	B-Line 1-5/8 GLV 12GA 2in Slotted Unistrut		1'-10"	3'-3"	3'-3"	
01	6	3 1/8"	B-LINE #2046					
03	3	2 1/8"	B-LINE #2038					

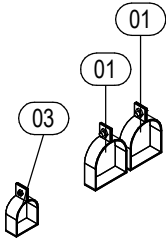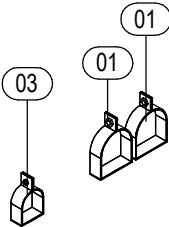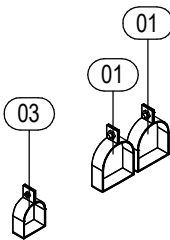

1 ISOMETRIC

SCALE:

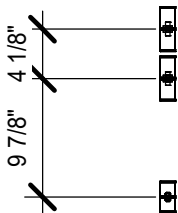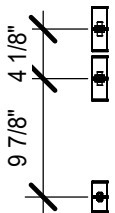


2 TOP VIEW

SCALE: 3/4" = 1'-0"

A1	A3	B1	B3
A2	A4	B2	B4


JOB:	WASH U NRB
TICKET:	PPHGR-L03-070
Drawn By: Author	
DATE: 08/21/21	DATE REQ:

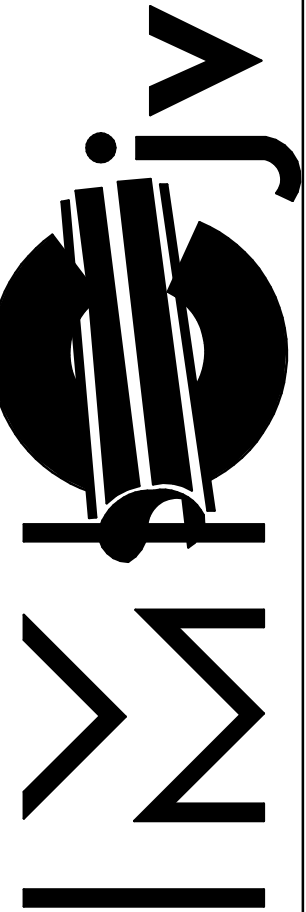


1233 N. Price Rd.  
St. Louis, Mo 63132-2303  
314-997-6600 phone

BIM 360//WUSM NRBWUSM RB\_PUF.rvt  
8/31/2021 10:07:30 AM

Mark	Qty	Size	Description	Length	Strut Width	Rod 1	Rod 2	Insulation
01	1	22"	B-Line 1-5/8 GRN 12GA 2in Slotted Unistrut		2' - 2"	3' - 3"	4' - 7"	
02	6	2"	B-Line BVT Series Vibra-Clamp Strut-Mnt Tube - ZN		0"	0"	0"	
03	1	16"	B-Line 1-5/8 GRN 12GA 2in Slotted Unistrut		1' - 8"	3' - 3"	3' - 3"	
04	1	16"	B-Line 1-5/8 GRN 12GA 2in Slotted Unistrut		1' - 8"	3' - 3"	4' - 7"	

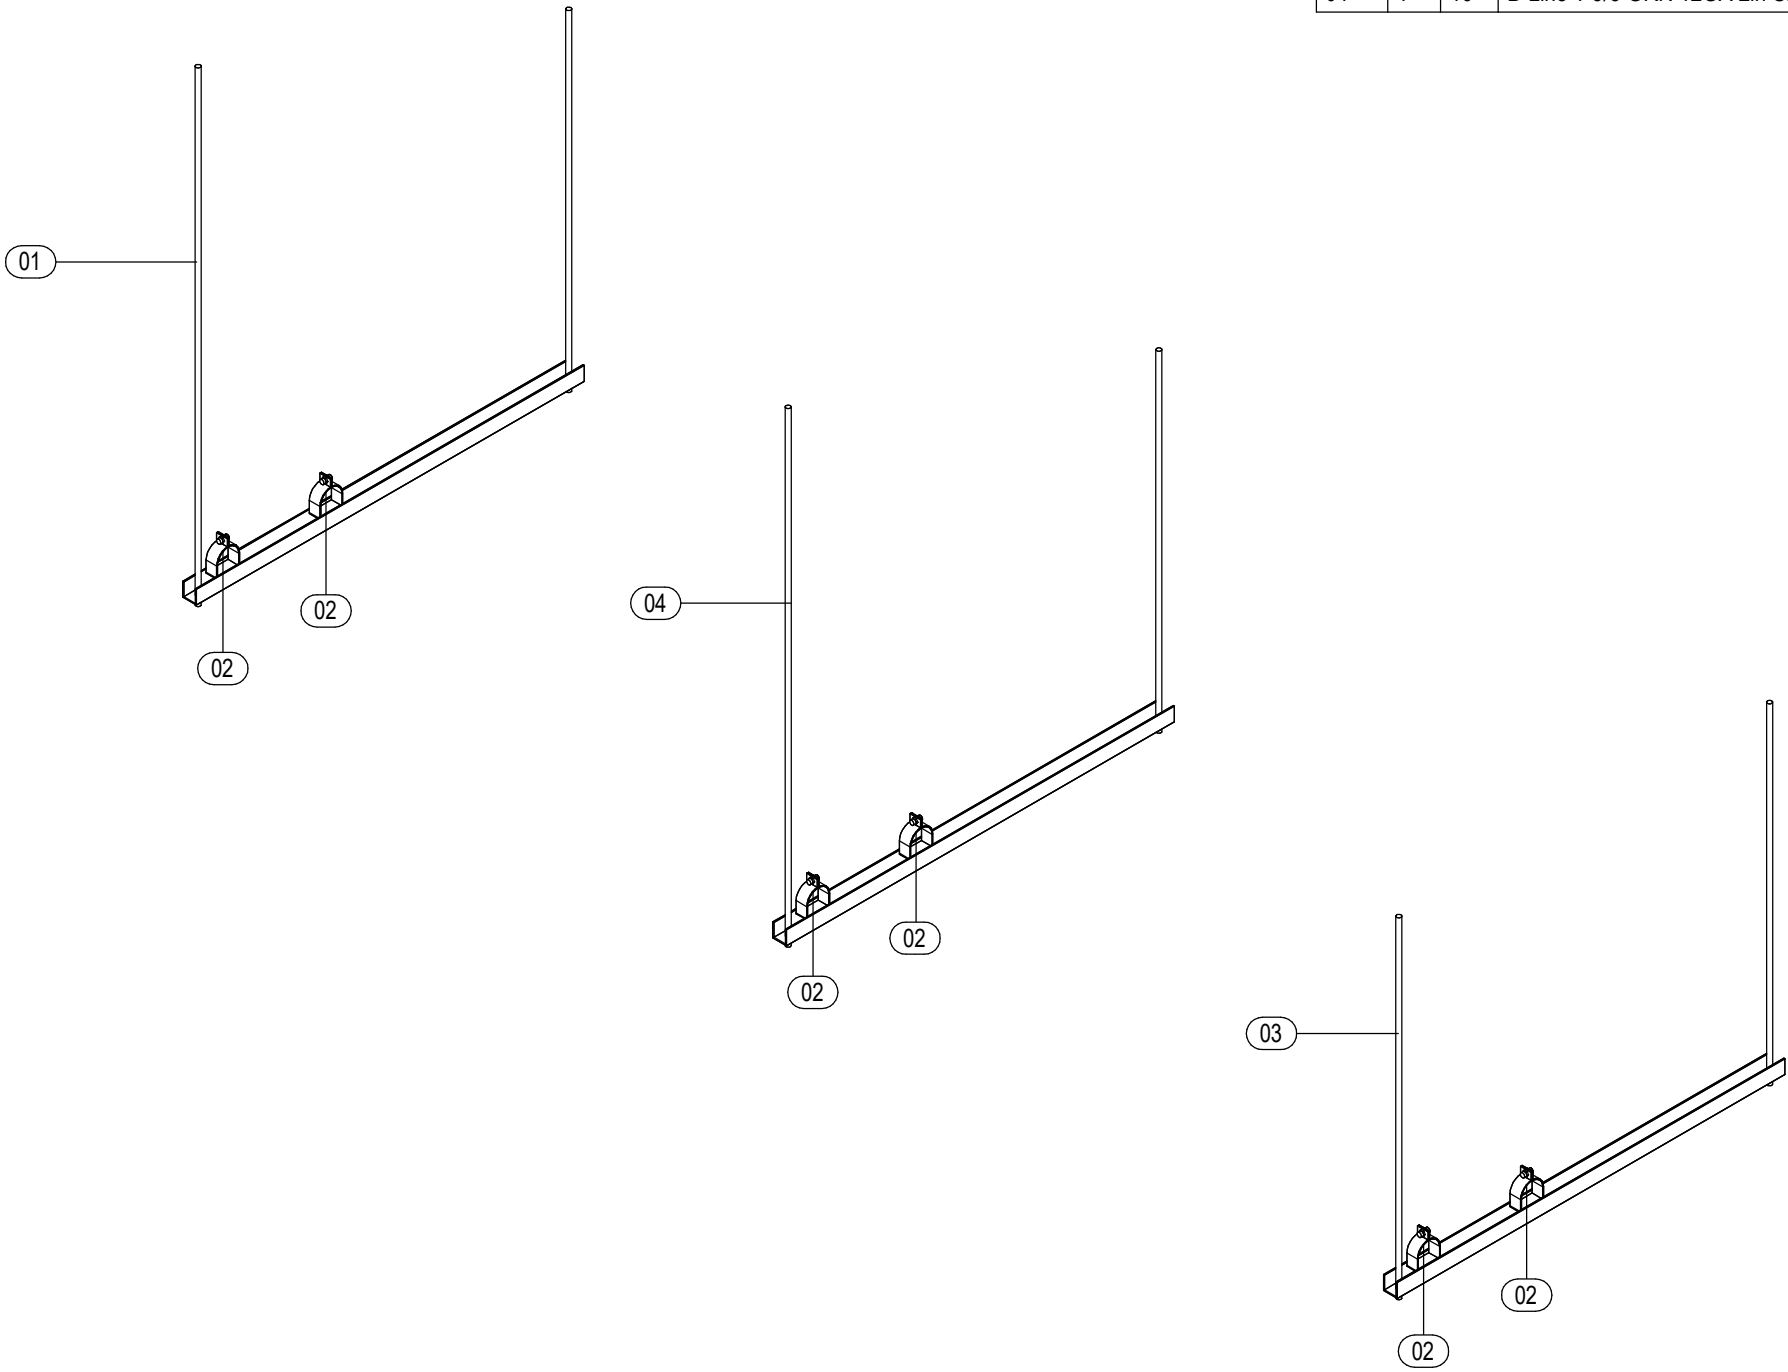


1 ISOMETRIC  
SCALE:

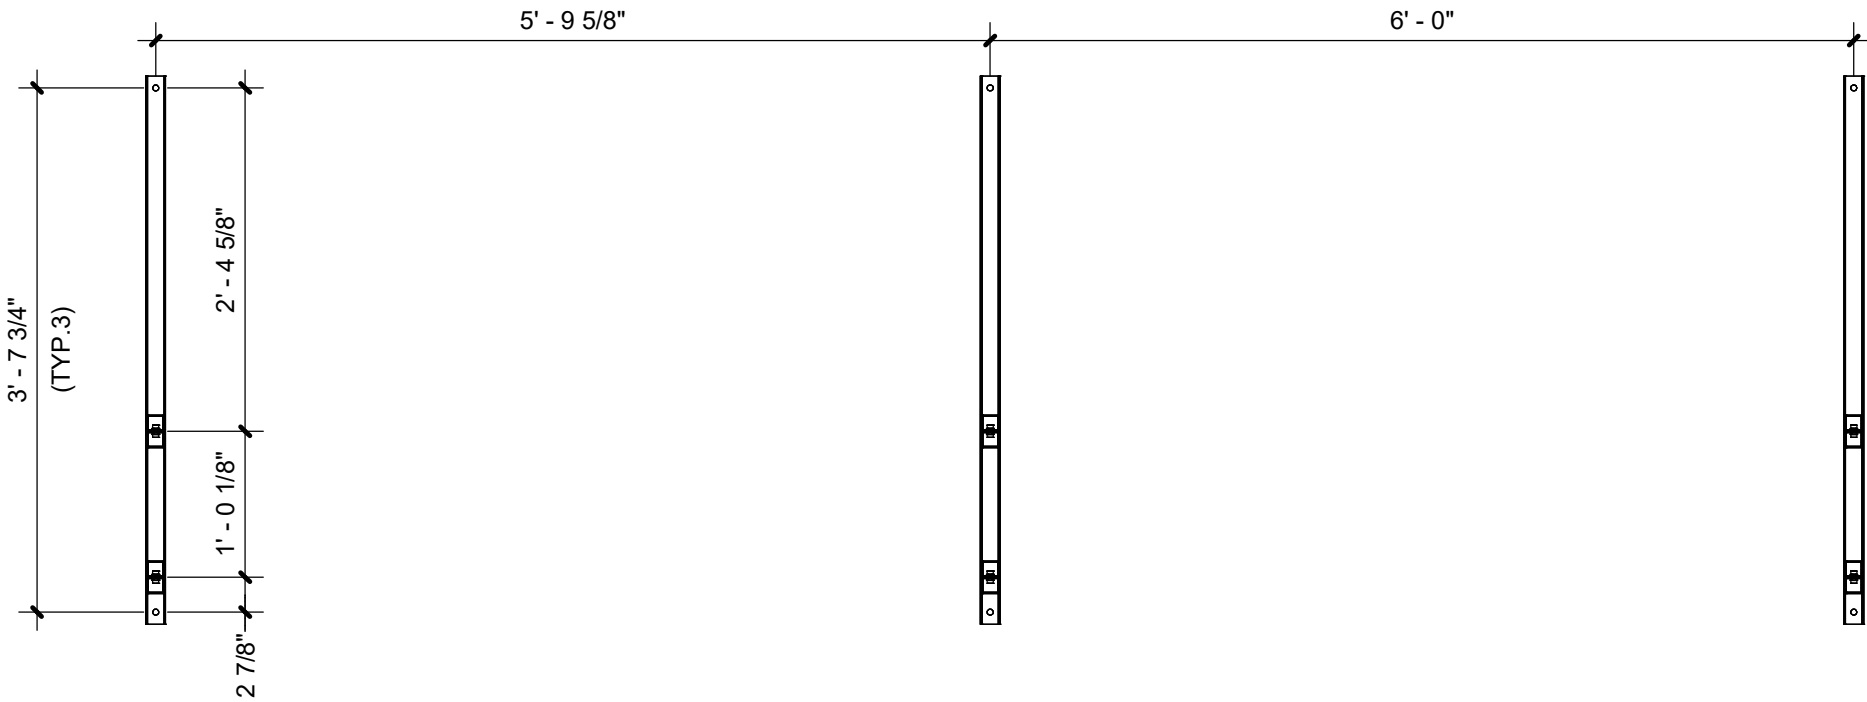

2 TOP VIEW  
SCALE: 3/4" = 1'-0"

A1	A3	B1	B3
A2	A4	B2	B4


JOB:	WASH U NRB
TICKET:	PUHGR-L03-070
Drawn By: Author	
DATE: 08/13/21	DATE REQ:

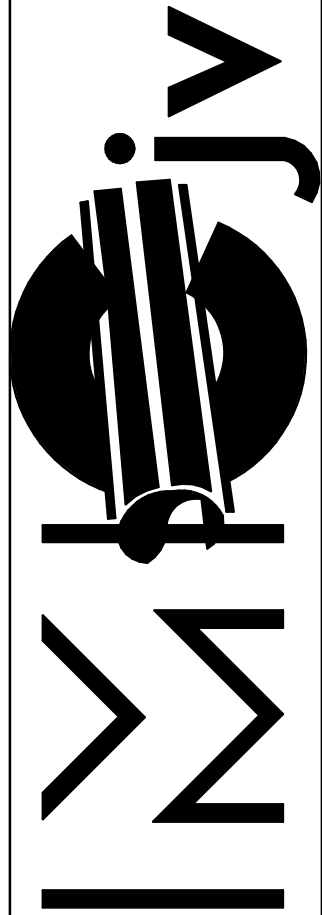


1233 N. Price Rd.  
St. Louis, Mo 63132-2303  
314-997-6600 phone

BIM 360://WUSM NRBWUSM\_RB\_PLF.rvt  
13-08-2021 18:14:53

Mark	Qty	Size	Description	Length	Strut Width	Rod 1	Rod 2	Insulation
01	1	1"	Cerro Type L Hard Copper Pipe	0'-4 1/4"				1/2"
02	1	3/4"	Cerro Type L Hard Copper Pipe	2'-11 5/8"				1/2"
03	1	1"	Cerro Type L Hard Copper Pipe	14'-4 7/8"				1/2"
04	1	1"x3/4"	Nibco Wrot 611R CxCxC Reducing Tee					1/2"
05	1	1"	Nibco Wrot 607 90 Deg Ell CxC					1/2"

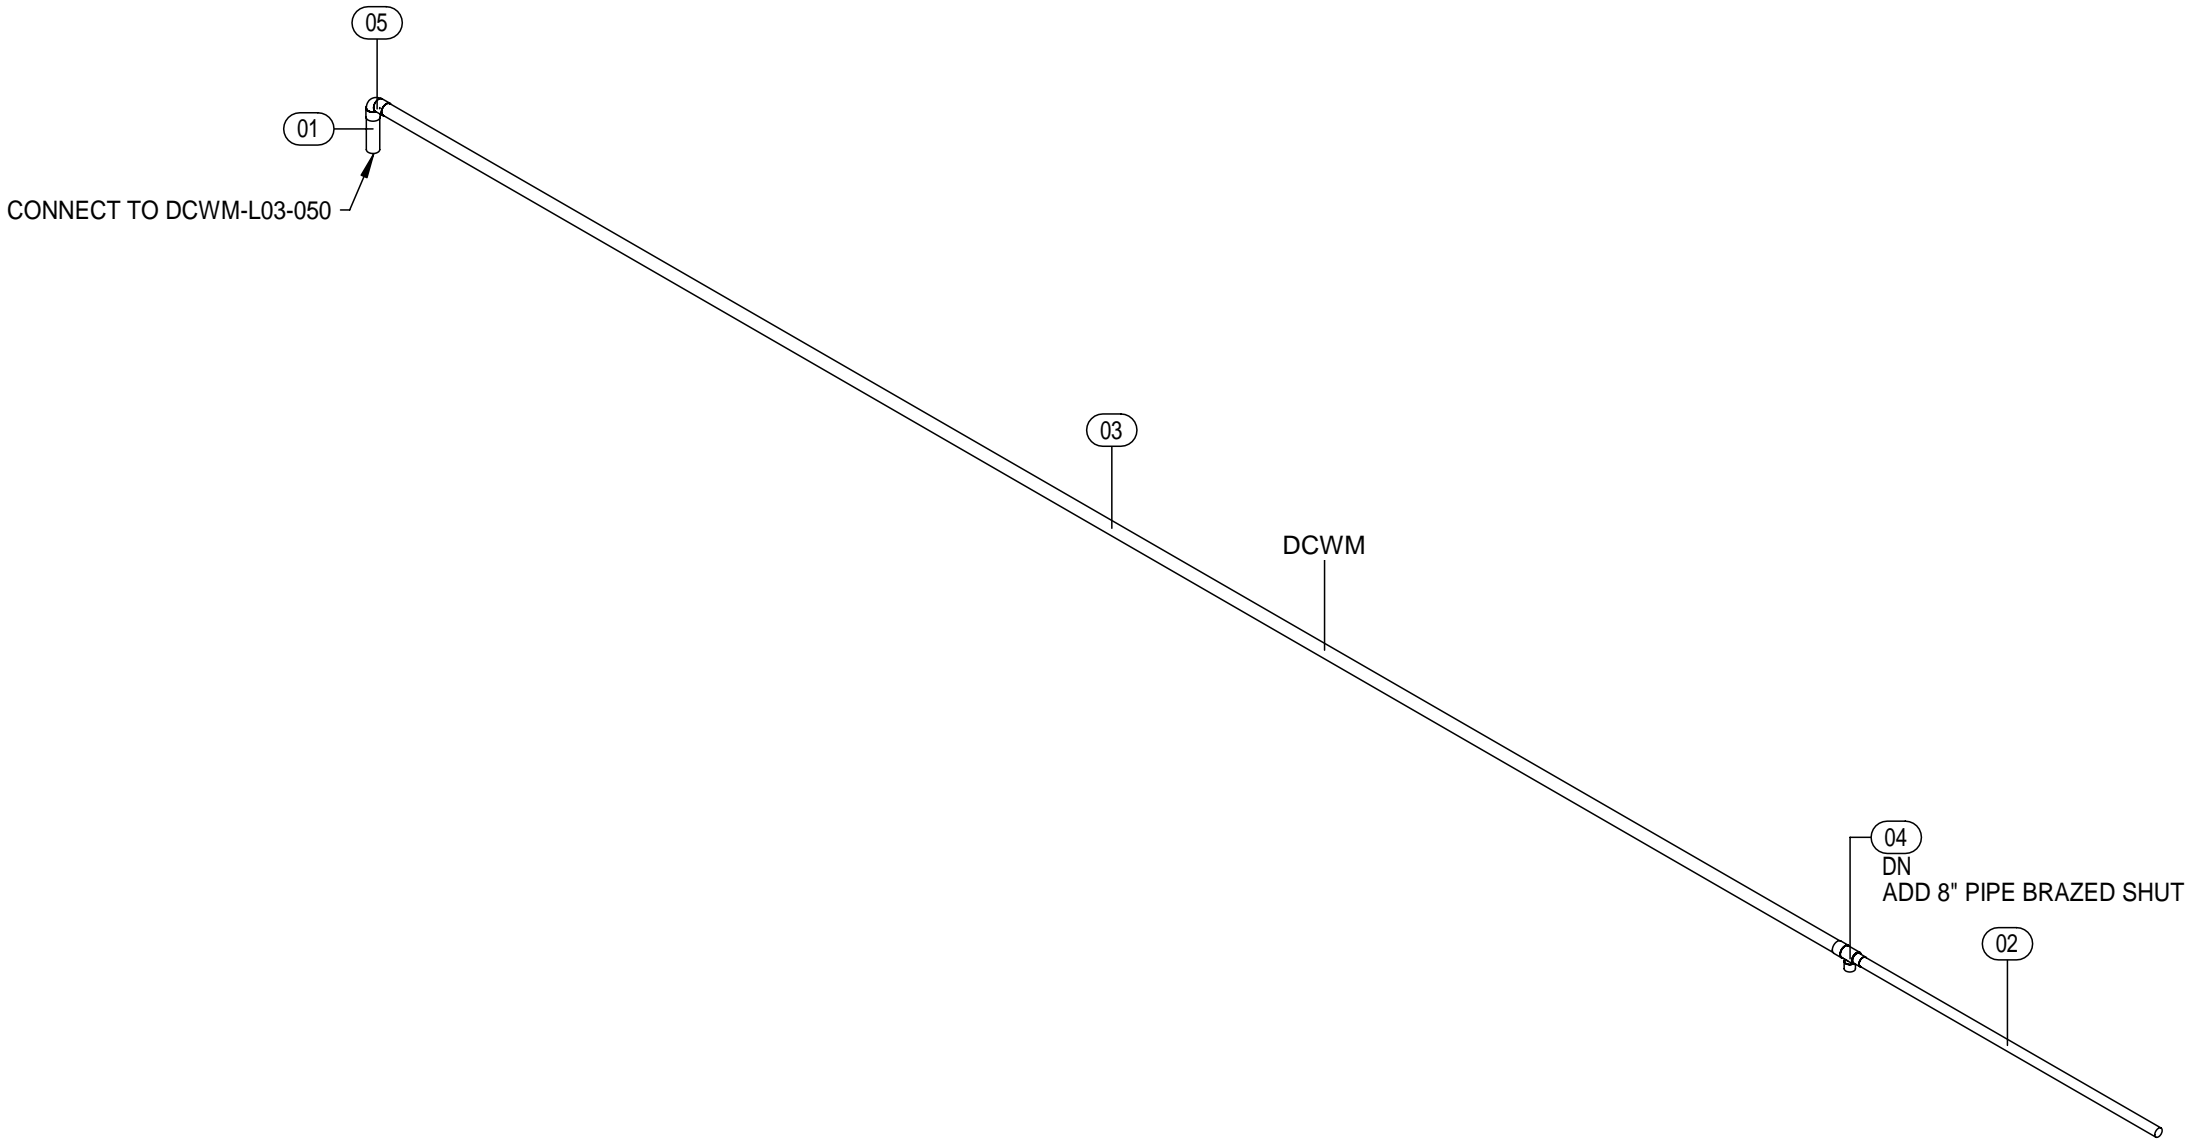


1 ISOMETRIC  
SCALE:

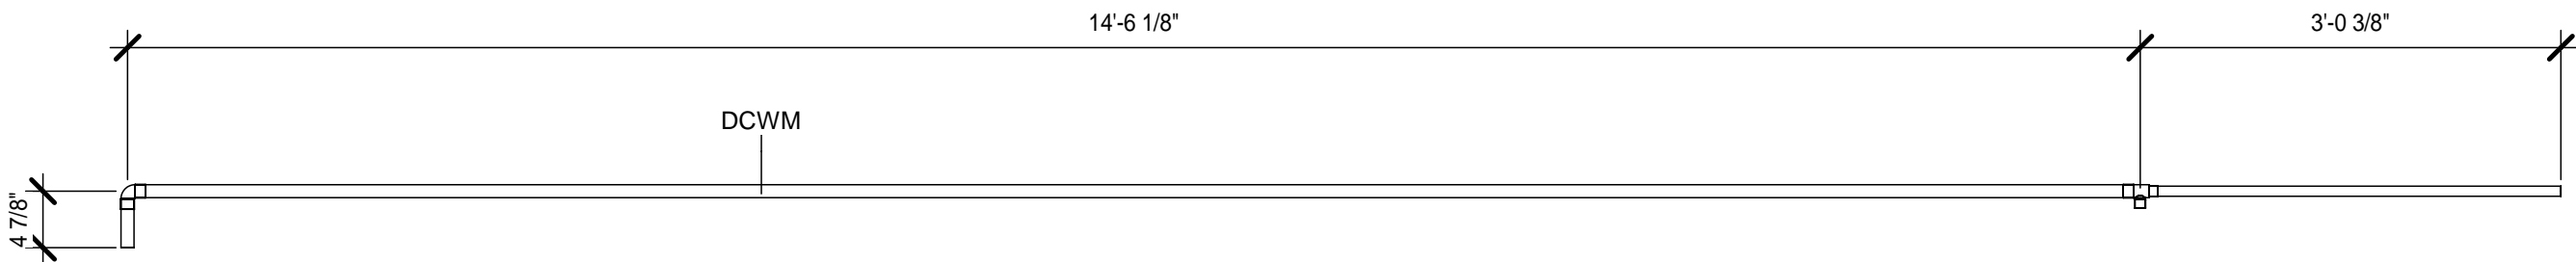

2 FRONT ELEVATION  
SCALE: 3/4" = 1'-0"


A1	A3	B1	B3
A2	A4	B2	B4

JOB:	WASH U NRB
TICKET:	DCWM-L03-070
Drawn By: Author	
DATE: 08/09/21	DATE REQ:

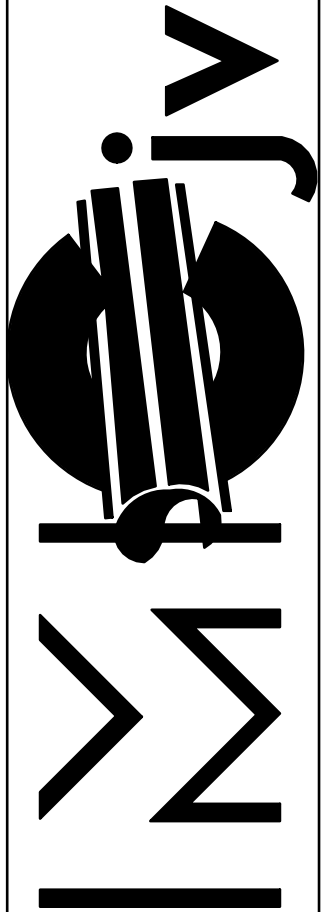


1233 N. Price Rd.  
St. Louis, Mo 63132-2303  
314-997-6600 phone

BIM 360://WUSM NRBWUSM\_RB\_PLF.rvt  
09-08-2021 15:57:08

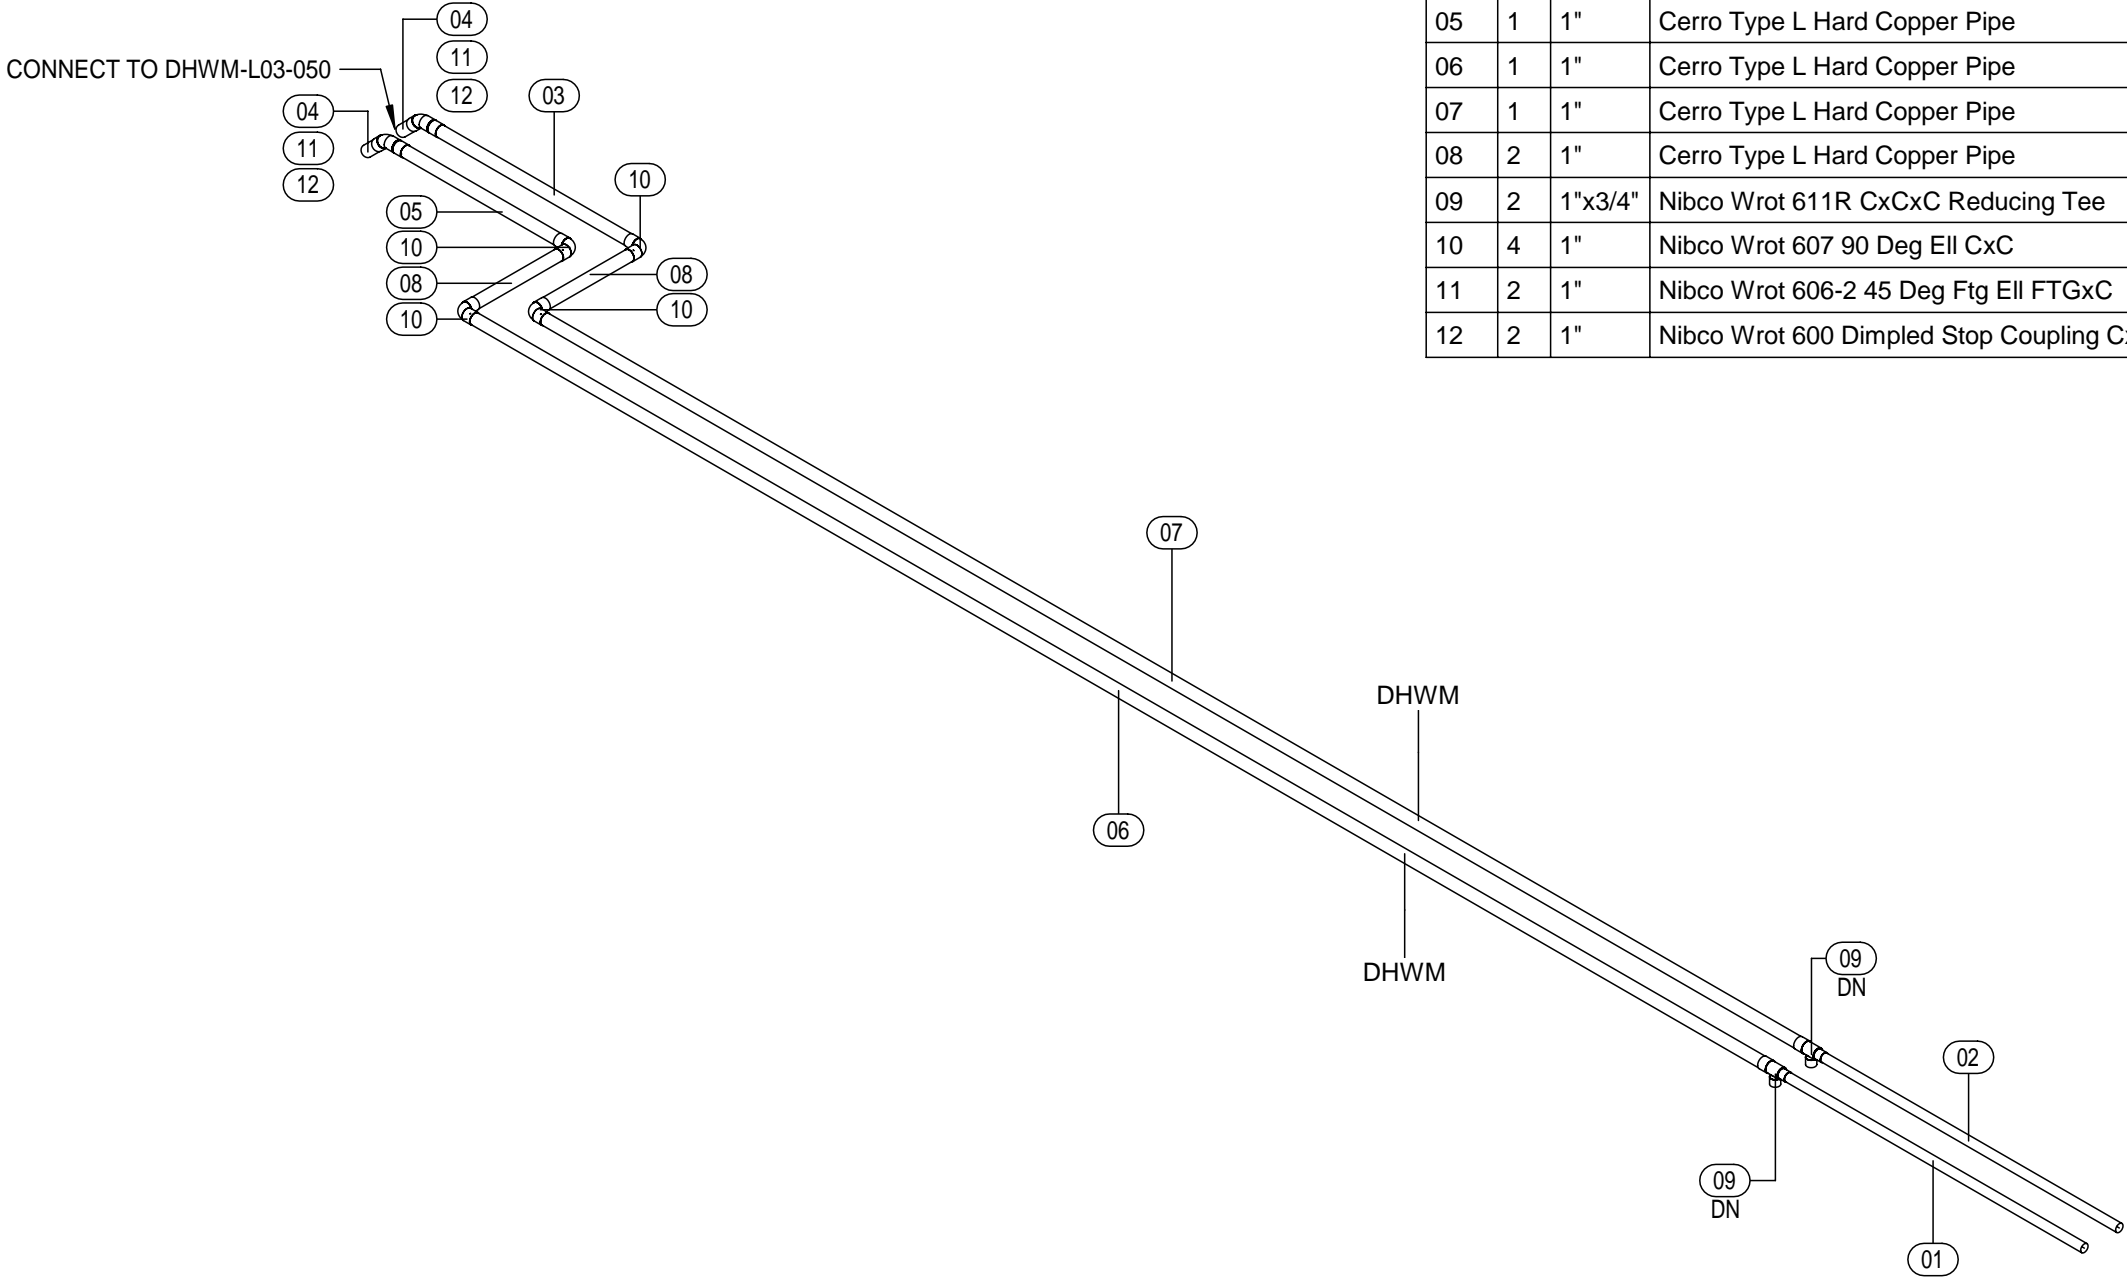

Mark	Qty	Size	Description	Length	Strut Width	Rod 1	Rod 2	Insulation
01	1	3/4"	Cerro Type L Hard Copper Pipe	2'-11 11/16"				1"
02	1	3/4"	Cerro Type L Hard Copper Pipe	2'-11 9/16"				1"
03	1	1"	Cerro Type L Hard Copper Pipe	2'-0 1/16"				1"
04	2	1"	Cerro Type L Hard Copper Pipe	0'-2 3/4"				1"
05	1	1"	Cerro Type L Hard Copper Pipe	1'-7 7/8"				1"
06	1	1"	Cerro Type L Hard Copper Pipe	12'-9 11/16"				1"
07	1	1"	Cerro Type L Hard Copper Pipe	12'-5 5/8"				1"
08	2	1"	Cerro Type L Hard Copper Pipe	0'-11 11/16"				1"
09	2	1"x3/4"	Nibco Wrot 611R CxCxC Reducing Tee					1"
10	4	1"	Nibco Wrot 607 90 Deg Ell CxC					1"
11	2	1"	Nibco Wrot 606-2 45 Deg Ftg Ell FTGxC					1"
12	2	1"	Nibco Wrot 600 Dimpled Stop Coupling CxC					1"


1 ISOMETRIC  
SCALE:

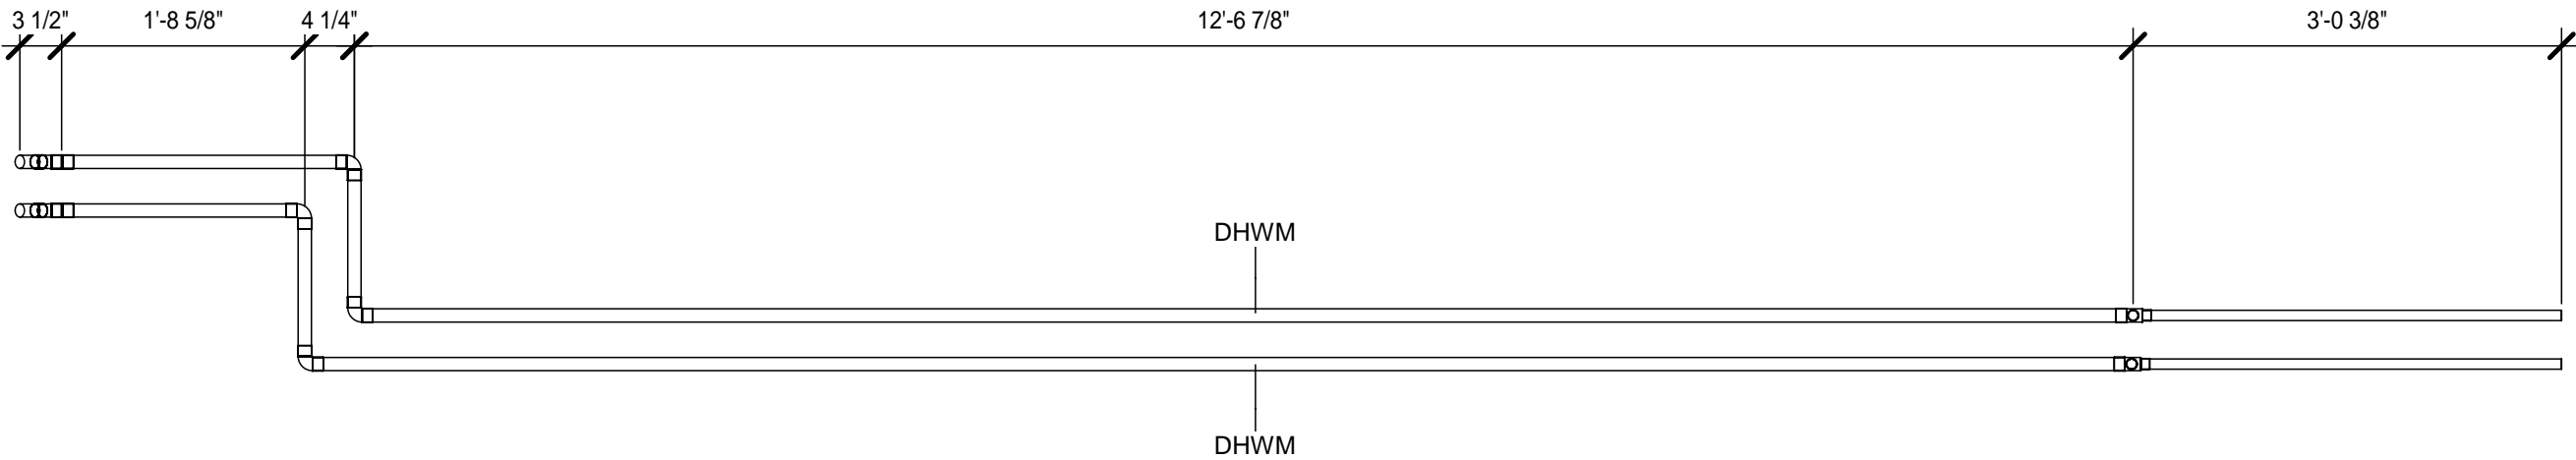

2 TOP VIEW  
SCALE: 3/4" = 1'-0"


A1	A3	B1	B3
A2	A4	B2	B4

JOB: WASH U NRB
TICKET: DHWM-L03-070
Drawn By: Author
DATE: 08/09/21
DATE REQ:

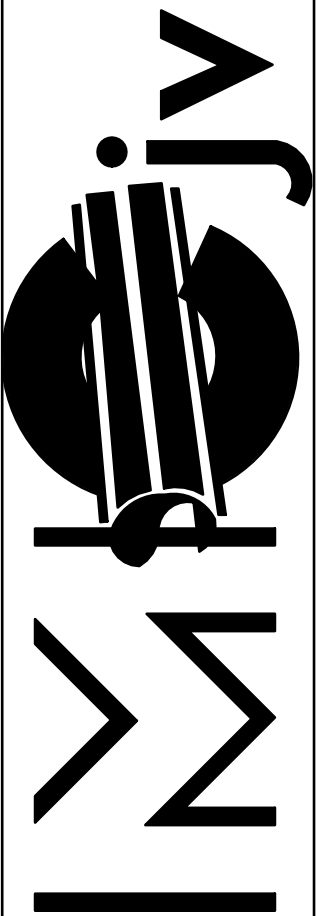


1233 N. Price Rd.  
St. Louis, Mo 63132-2303  
314-997-6600 phone

BIM 360/WUSM NRBWUSM\_RB\_PUF.rvt  
17-08-2021 17:44:08

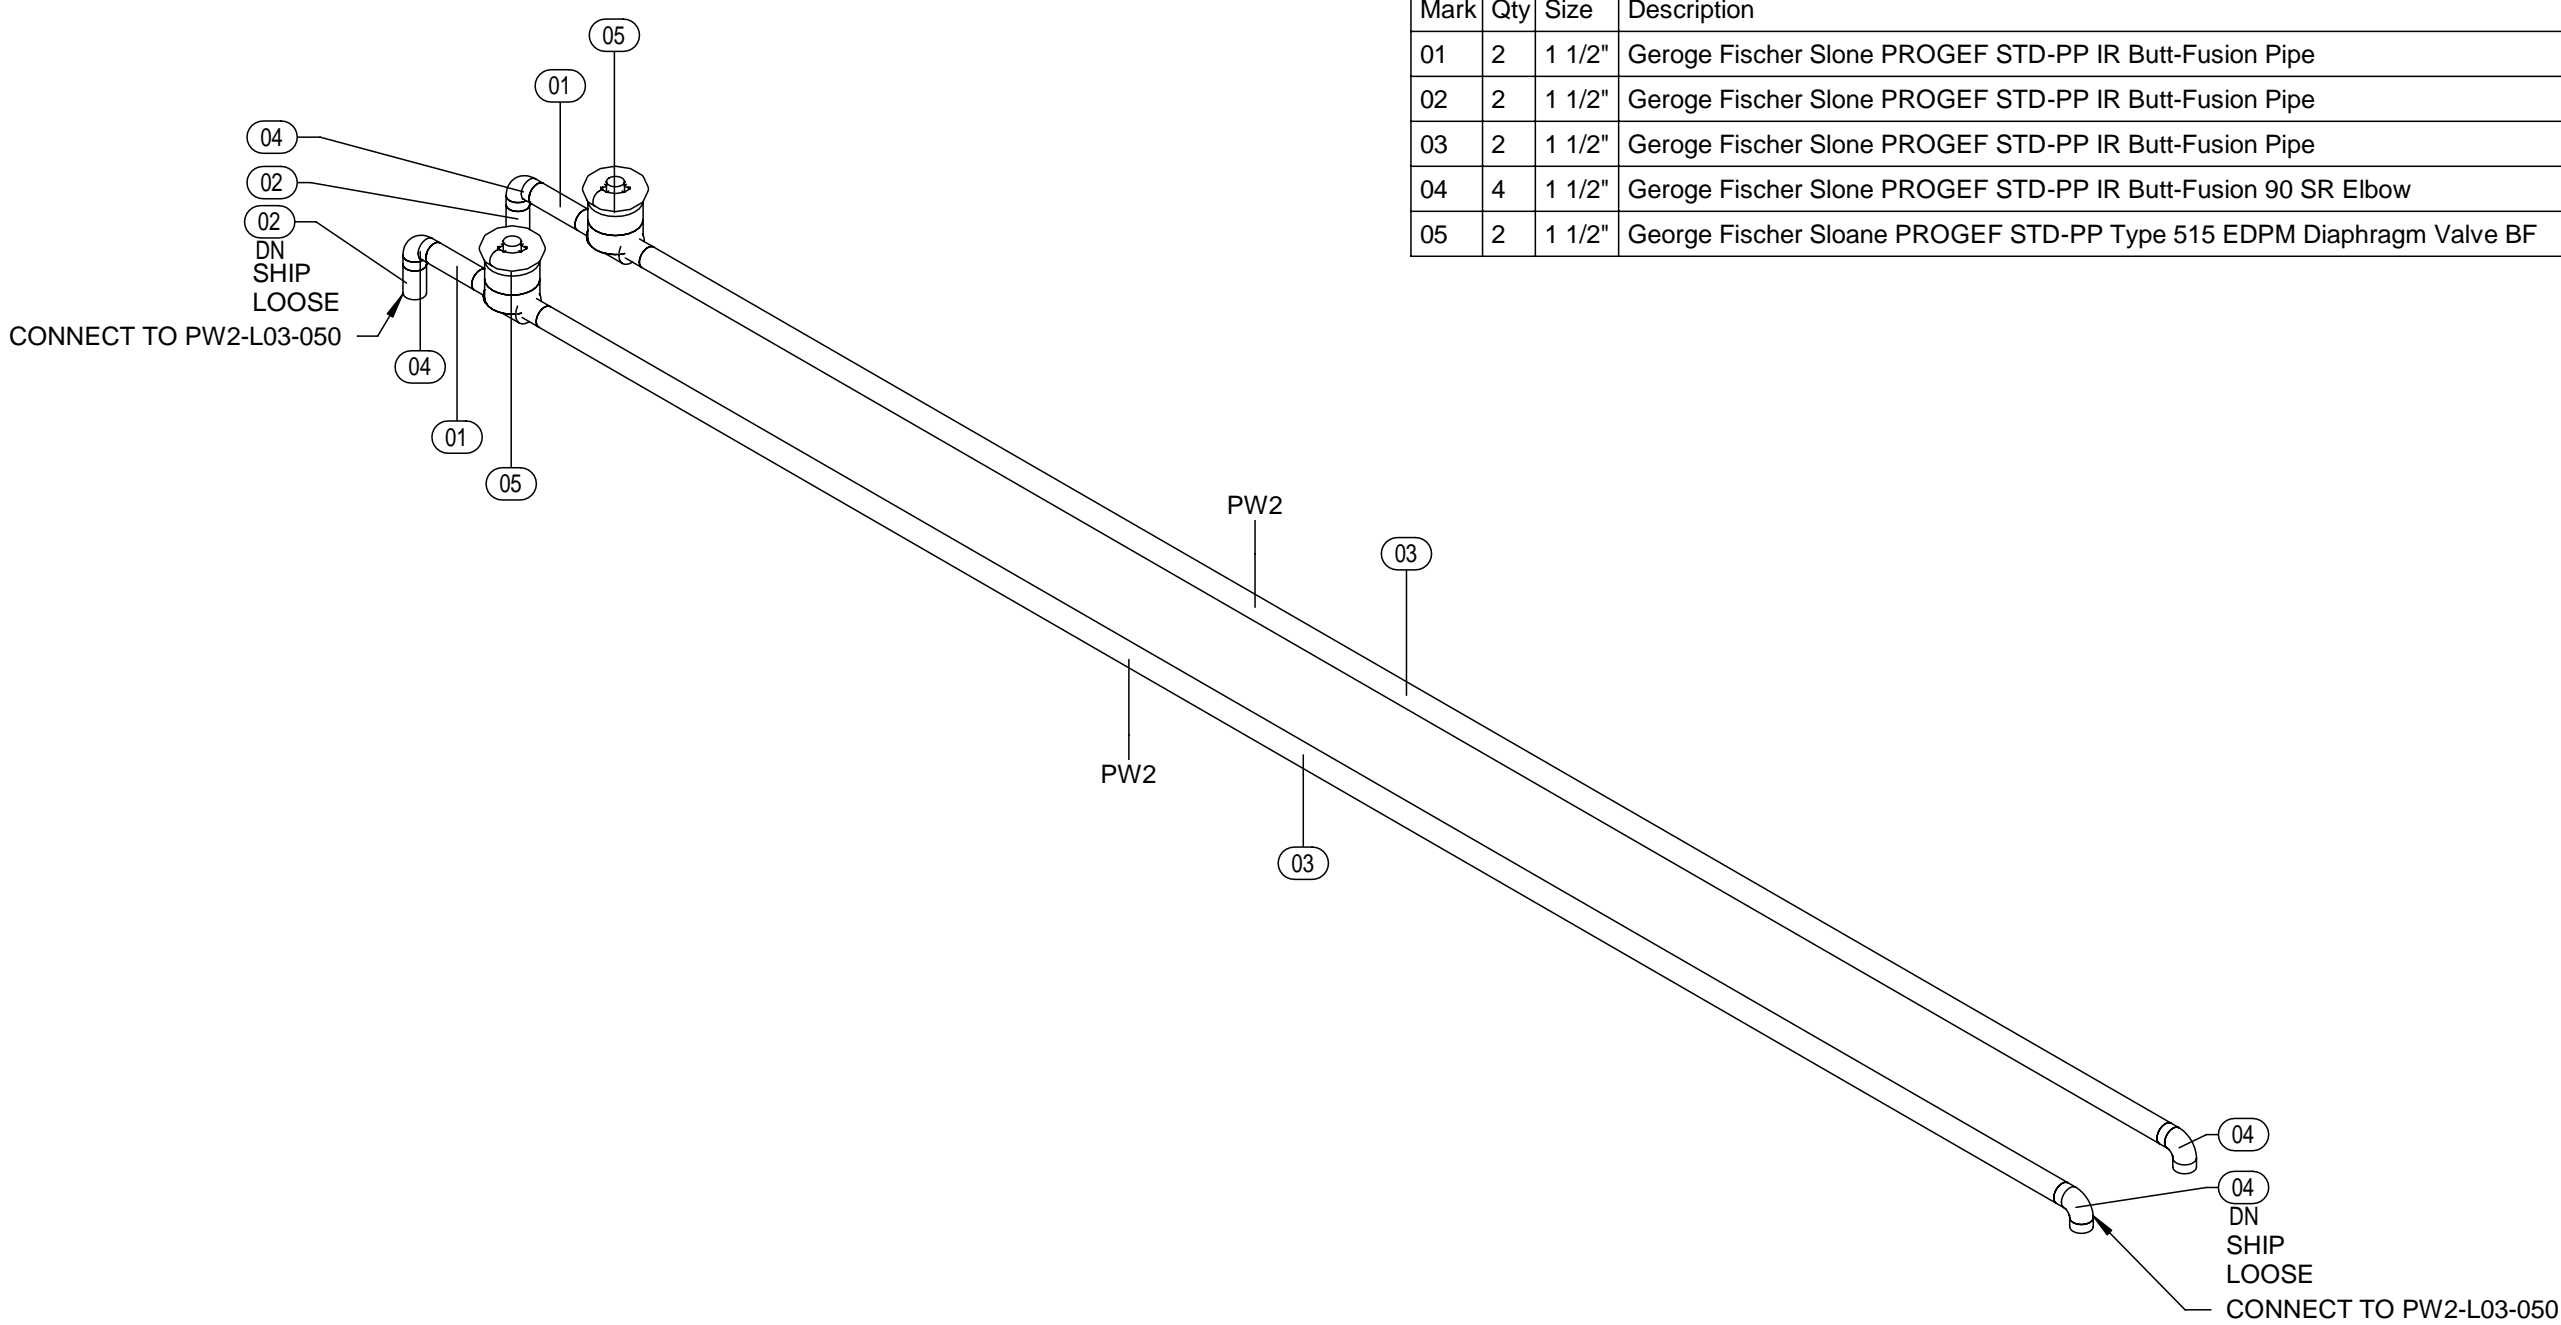


Mark	Qty	Size	Description	Length	Strut Width	Rod 1	Rod 2	Insulation
01	2	1 1/2"	Geroge Fischer Slone PROGEF STD-PP IR Butt-Fusion Pipe	0'-5 7/16"				
02	2	1 1/2"	Geroge Fischer Slone PROGEF STD-PP IR Butt-Fusion Pipe	0'-2 15/16"				
03	2	1 1/2"	Geroge Fischer Slone PROGEF STD-PP IR Butt-Fusion Pipe	14'-10 15/16"				
04	4	1 1/2"	Geroge Fischer Slone PROGEF STD-PP IR Butt-Fusion 90 SR Elbow					
05	2	1 1/2"	George Fischer Sloane PROGEF STD-PP Type 515 EDPM Diaphragm Valve BF					

1 ISOMETRIC  
SCALE:

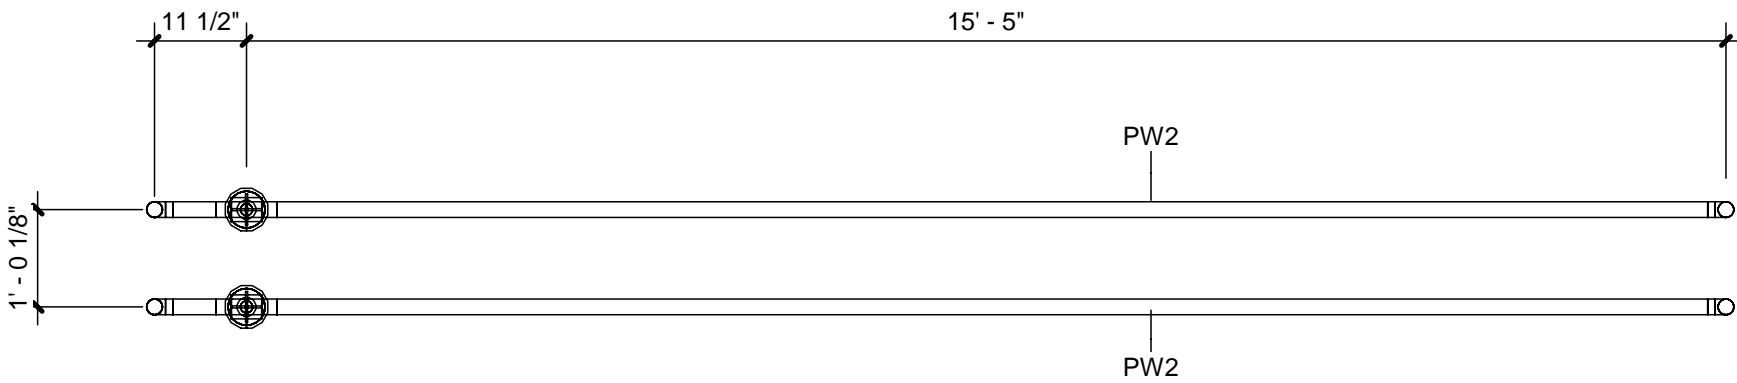

2 TOP VIEW  
SCALE: 1/2" = 1'-0"

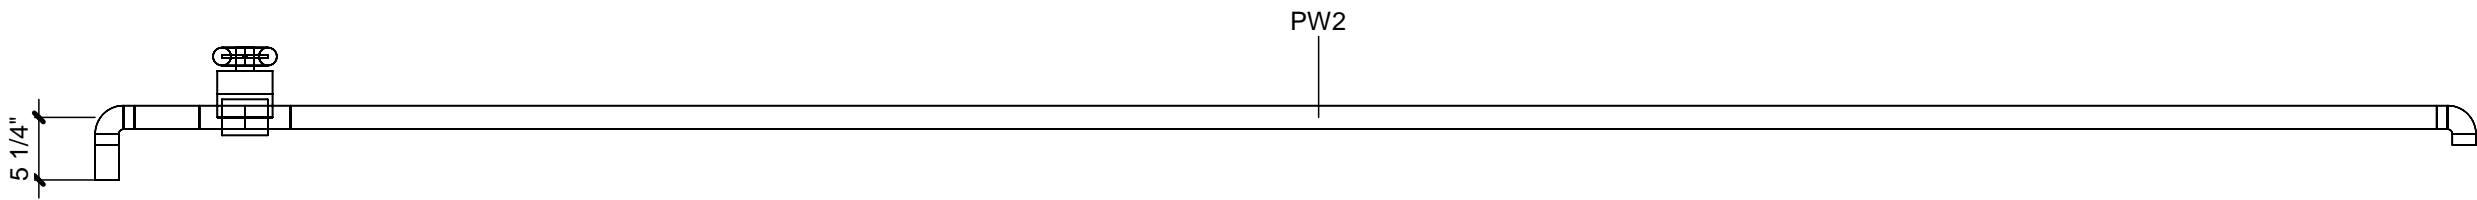

3 FRONT ELEVATION  
SCALE: 3/4" = 1'-0"


A1	A3	B1	B3
A2	A4	B2	B4

JOB: WASH U NRB

TICKET: PW2-L03-070

Drawn By: Author

DATE: 08/13/21 DATE REQ:

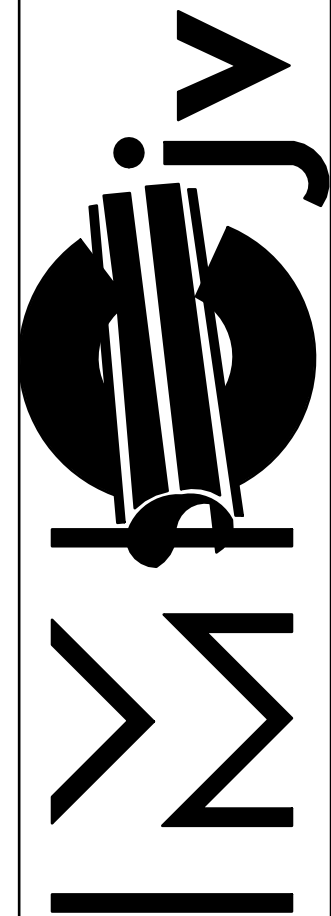

1233 N. Price Rd.  
St. Louis, Mo 63132-2303  
314-997-6600 phone