



BIM 360//WUSM NRBWUSM\_RB\_SPOOLING MASTER.rvt  
10/19/2021 1:50:20 PM

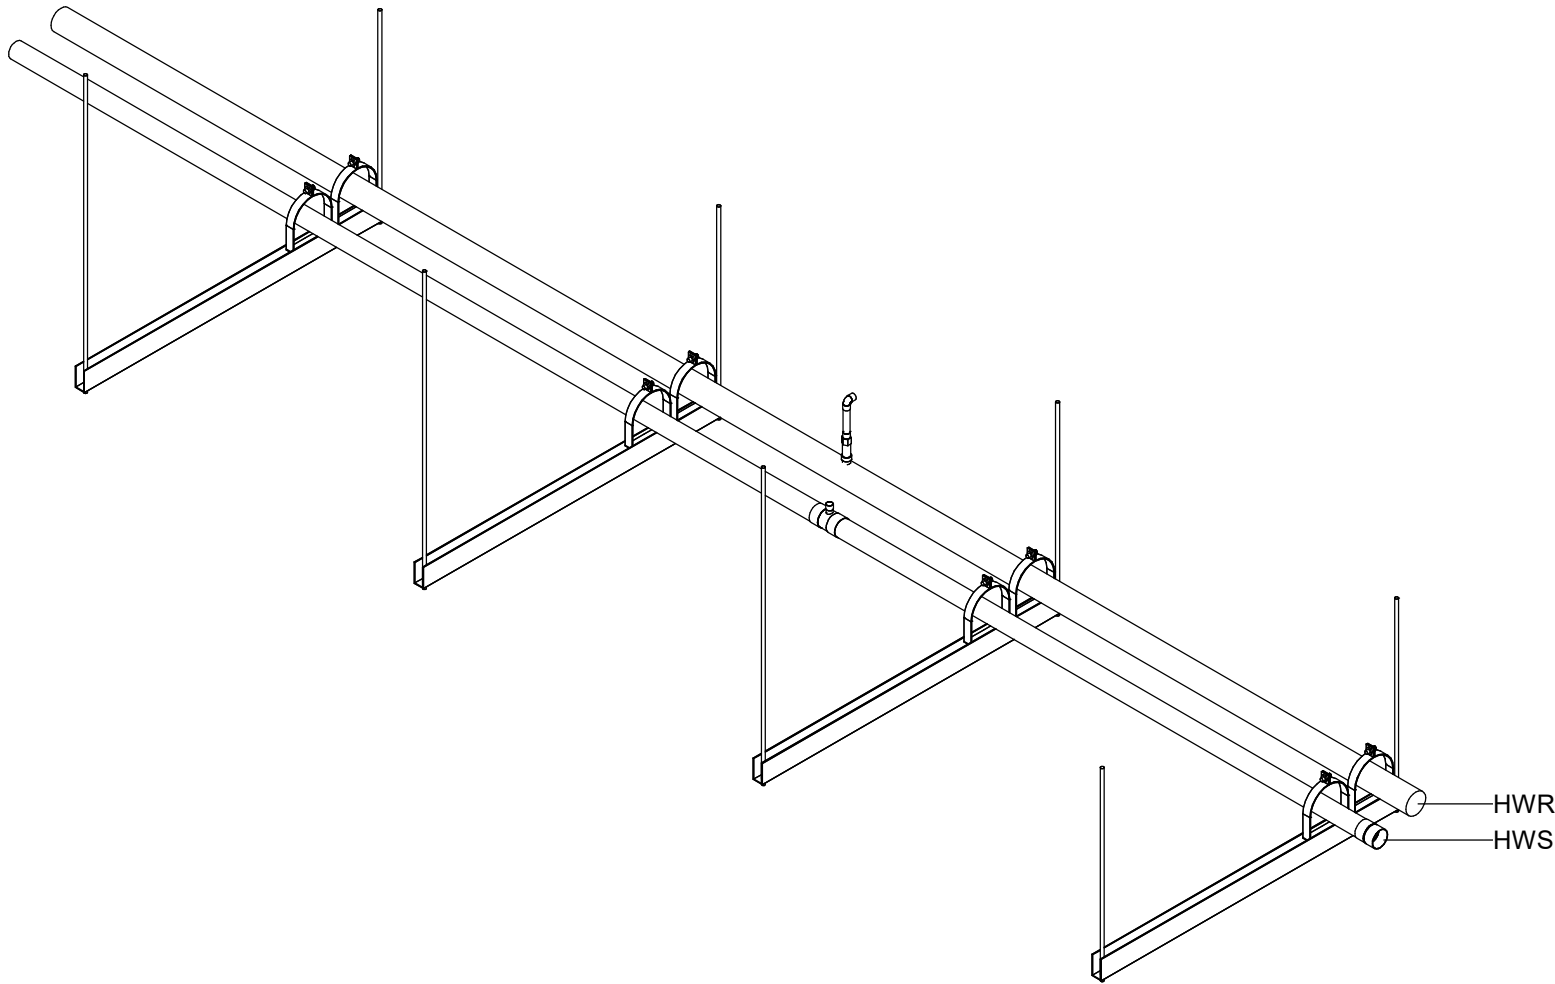


1 **AS-L06-004 - ISOMETRIC**  
AS-L06-004 SCALE:

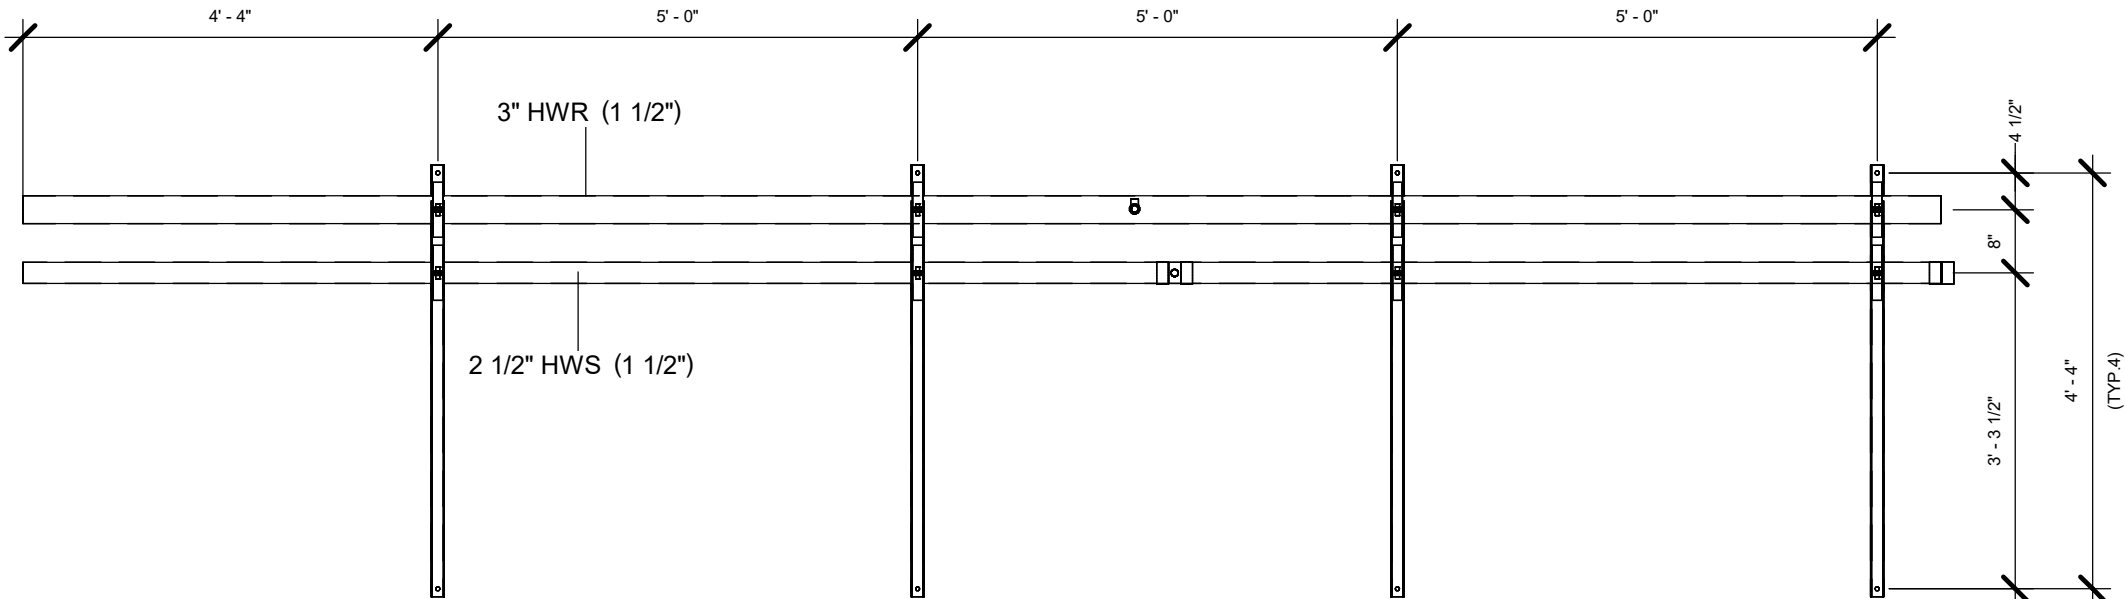

2 **AS-L06-004**  
AS-L06-004 SCALE: 1/2" = 1'-0"

A1	A3	B1	B3
A2	A4	B2	B4

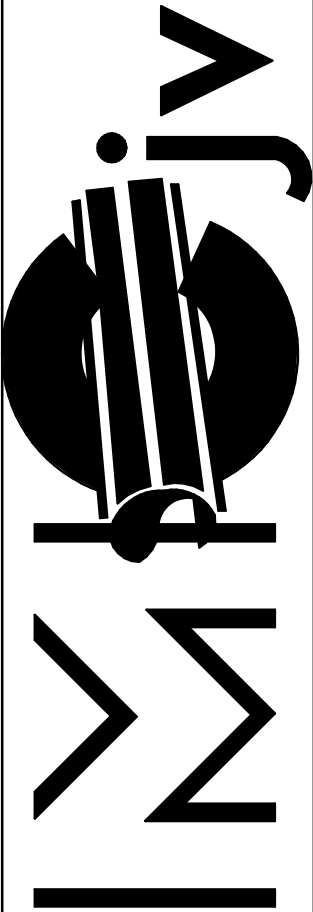

1233 N. Price Rd.  
St. Louis, Mo 63132-2303  
314-997-6600 phone

JOB: WASH U NRB


TICKET: AS-L06-004

Drawn By: Author


DATE: 10/08/21 DATE REQ:

BIM 360://WUSM NRBWUSM\_RB\_HPF.rvt  
10/21/2021 12:18:58 PM


Mark	Qty	Size	Description	Length	Strut Width	Rob 1	Rob 2	Insulation
<del>01</del>	<del>0</del>	<del>6"</del>	<del>B-Line B2000 ZN-Gal 10 Pipe Clamp</del>					
02	1	50"	B-Line 1-5/8 GRN 12GA Bk/Bk 2in Slotted Unistrut		4' - 6"	2' - 8 5/8"	2' - 8 5/8"	
03	3	50"	B-Line 1-5/8 GRN 12GA Bk/Bk 2in Slotted Unistrut		4' - 6"	4' - 0 5/8"	2' - 8 5/8"	
01	4	6 5/8"	B-LINE #2020					
04	4	5 5/8"	B-LINE #2066					

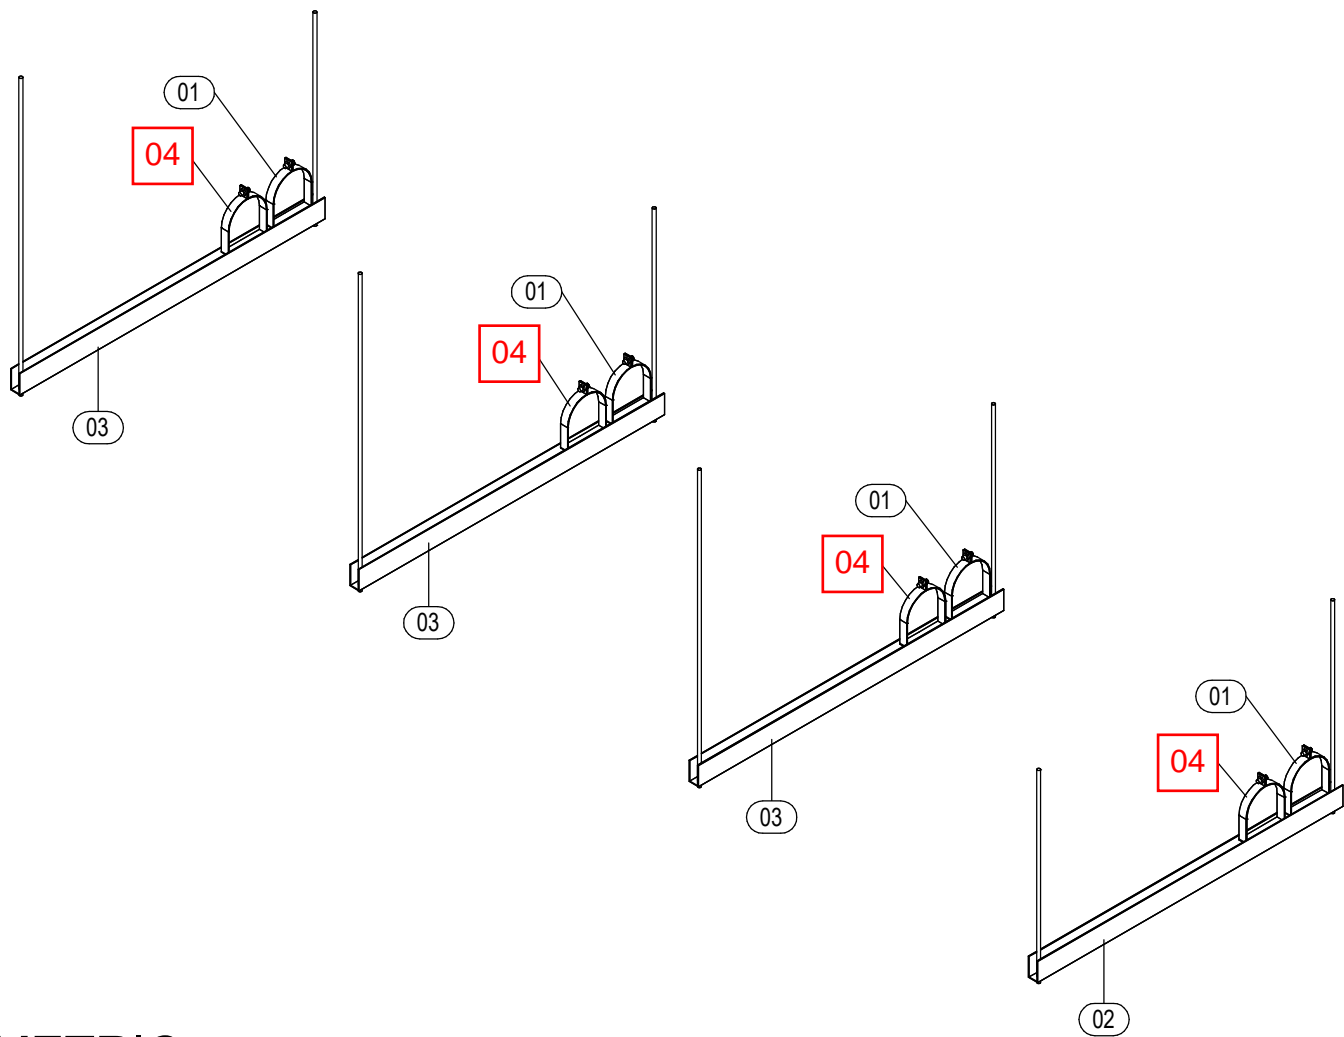

1 ISOMETRIC

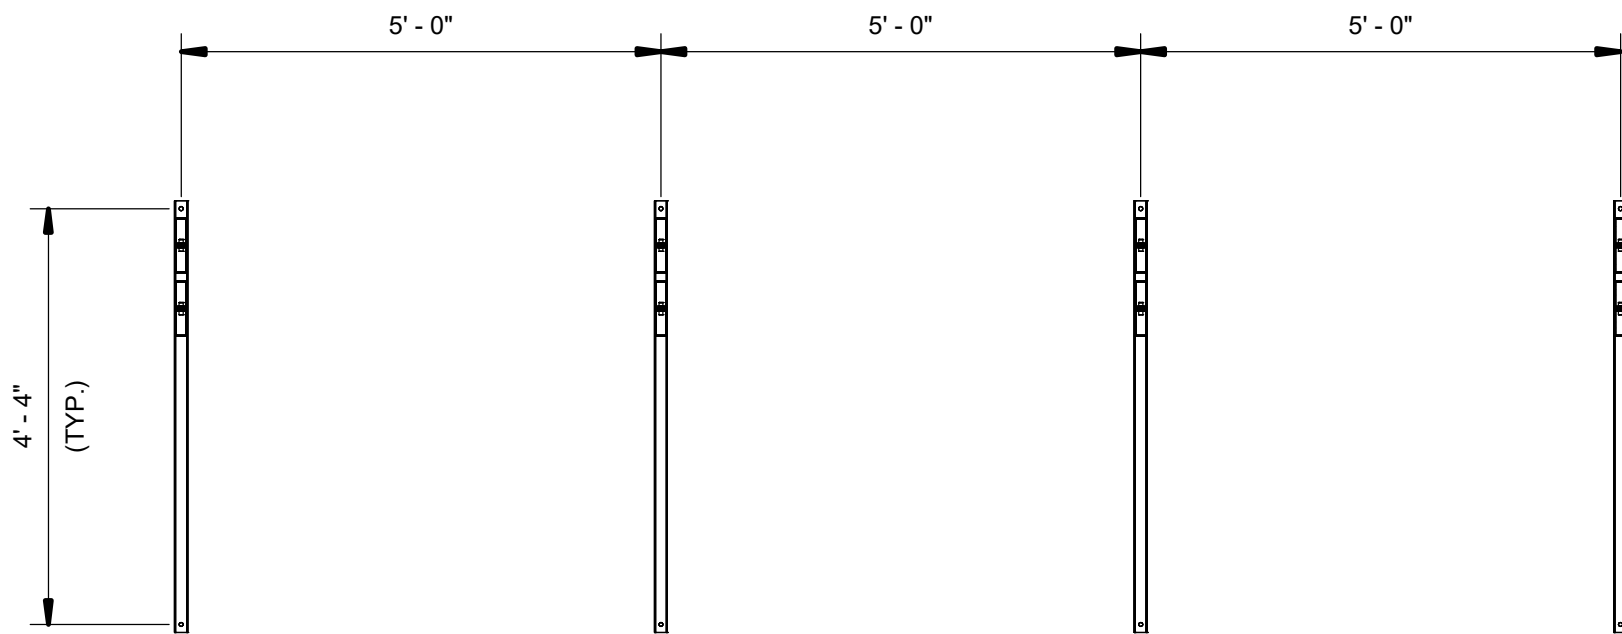


2 TOP VIEW

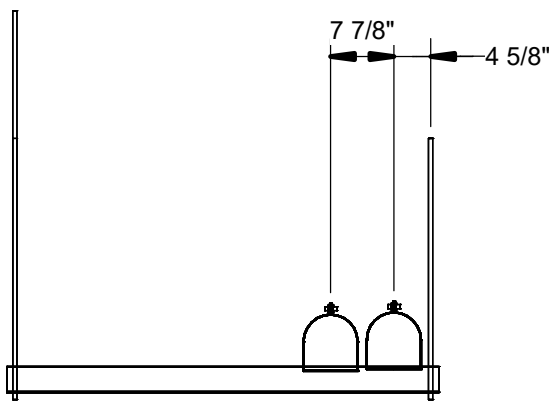

3 RIGHT ELEVATION

A1	A3	B1	B3
A2	A4	B2	B4


JOB:	WASH U NRB
TICKET:	HPHGR-L06-004
Drawn By: Author	
DATE: 10/08/21	DATE REQ:

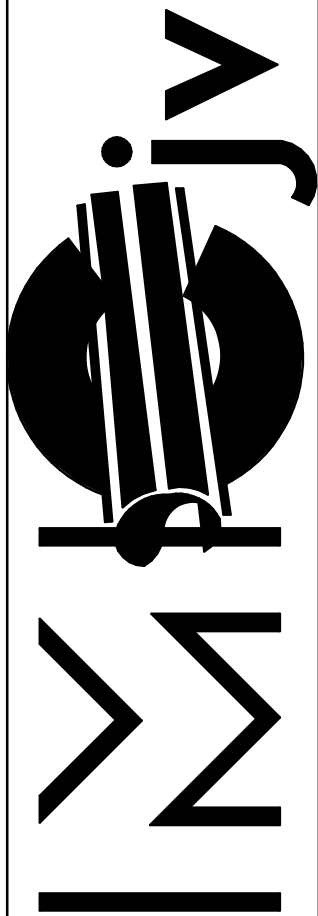


1233 N. Price Rd.  
St. Louis, Mo 63132-2303  
314-997-6600 phone

BIM 360//WUSM NRBWUSM\_RB\_HPF.rvt  
10/21/2021 2:21:14 PM

Mark	Qty	Size	Description	Length	Strut Width	Rob 1	Rob 2	Insulation
<del>01</del>	1	<del>3/4"</del>	<del>Cerro Type K Hard Copper Pipe</del>	<del>8'-5 11/16"</del>				<del>1"</del>
02	1	3"	Chicago Area Sch 40 SA-53B CS ERW Pipe PE	19'-11 7/8"				1 1/2"
03	1	3/4"	Victaulic No.647 TT Dielectric Transition Fitting					1"
<del>04</del>	1	<del>3/4"</del>	<del>Nibco Wrot 607-00 Dwg Ell GxG</del>					<del>1"</del>
<del>05</del>	1	<del>3/4"</del>	<del>Nibco Wrot 603 Adapter GxF</del>					<del>1"</del>
06	1	3/4"	Generic Solder Joint					1"
07	1	3"x3/4"	Anvil 3000# FS Thread-O-Let					1"

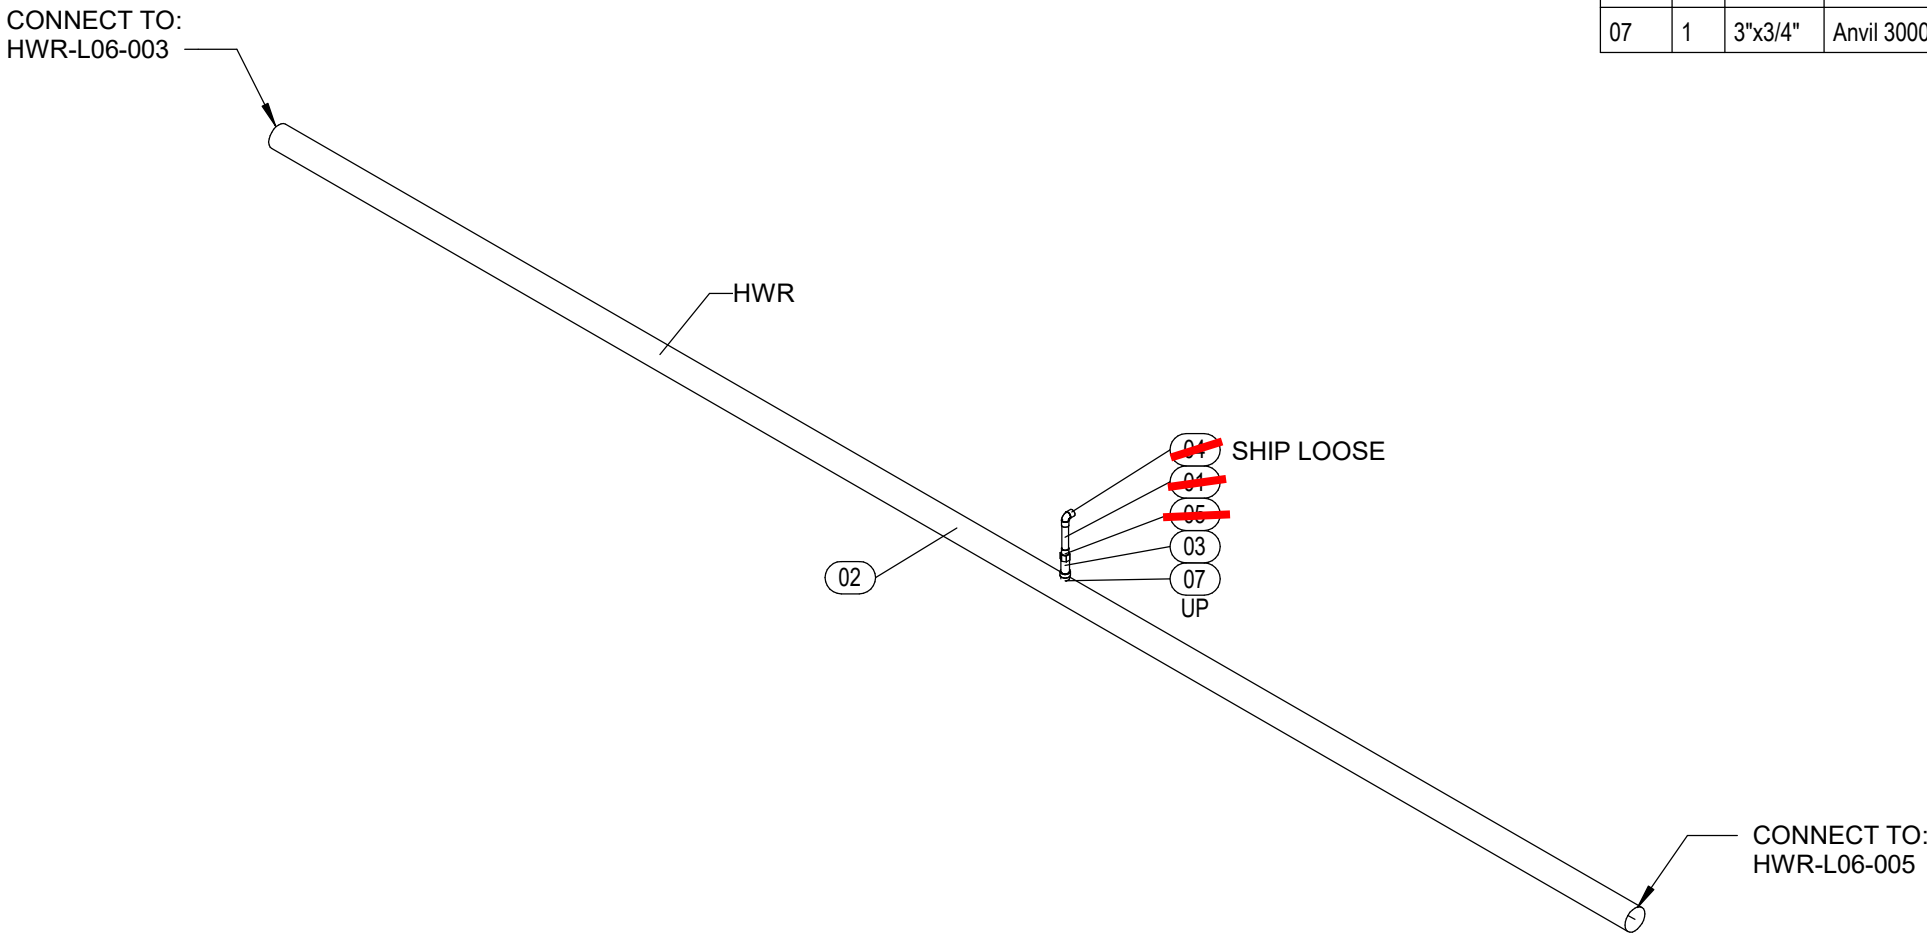

1 ISOMETRIC  
SCALE:

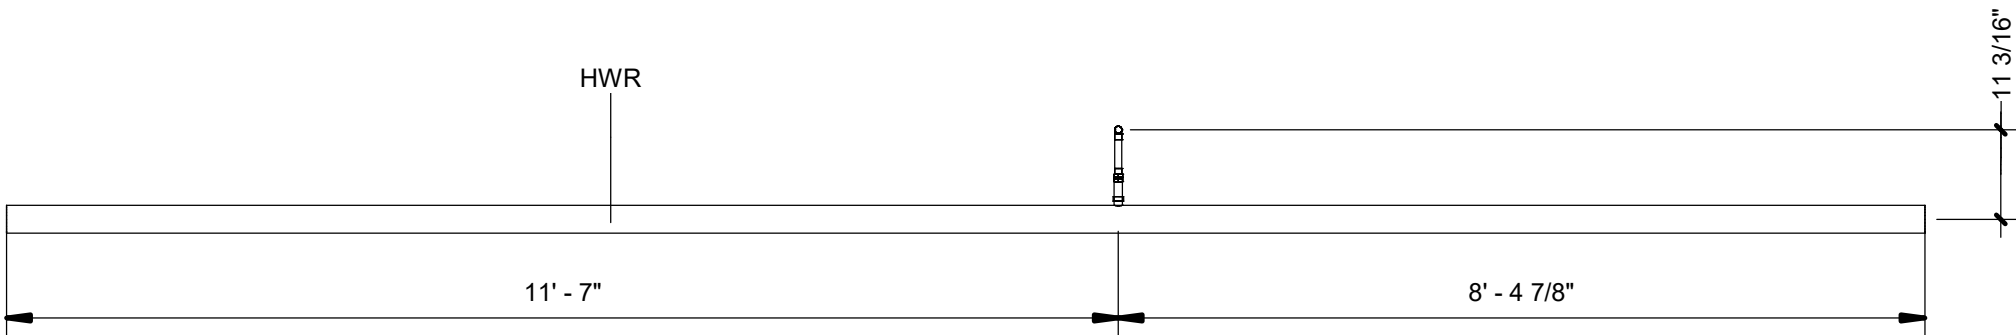

2 LEFT ELEVATION  
SCALE: 1/2" = 1'-0"

A1	A3	B1	B3
A2	A4	B2	B4


JOB: WASH U NRB

TICKET: HWR-L06-004

Drawn By: Author

DATE: 10/08/21


DATE REQ:

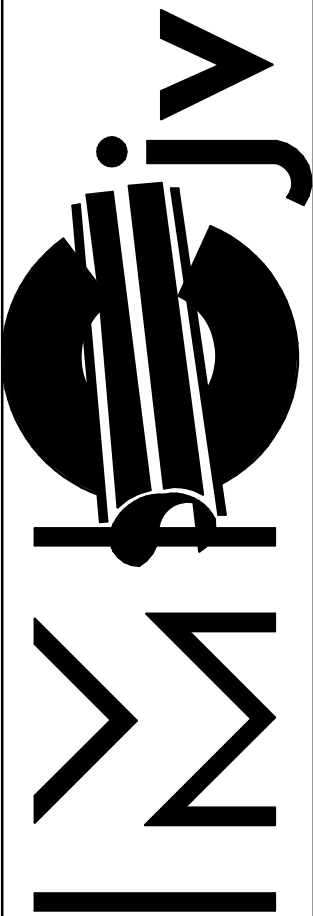

1233 N. Price Rd.  
St. Louis, Mo 63132-2303  
314-997-6600 phone


BIM 360://WUSM NRBWUSM\_RB\_HPF.rvt  
10/21/2021 2:23:21 PM

Mark	Qty	Size	Description	Length	Strut Width	Rob 1	Rob 2	Insulation
01	1	2 1/2"	Cerro Type K Hard Copper Pipe	7'-11 1/16"				1 1/2"
02	1	2 1/2"	Cerro Type K Hard Copper Pipe	11'-11 1/4"				1 1/2"
03	1	2 1/2"x3/4"x2 1/2"	Nibco Wrot 611R CxCxC Reducing Tee					1 1/2"
04	1	2 1/2"	Nibco Wrot 600 Dimpled Stop Coupling CxC					1 1/2"
05	1	3/4"	Generic Solder Joint					1"
06	2	2 1/2"	Generic Solder Joint					1 1/2"

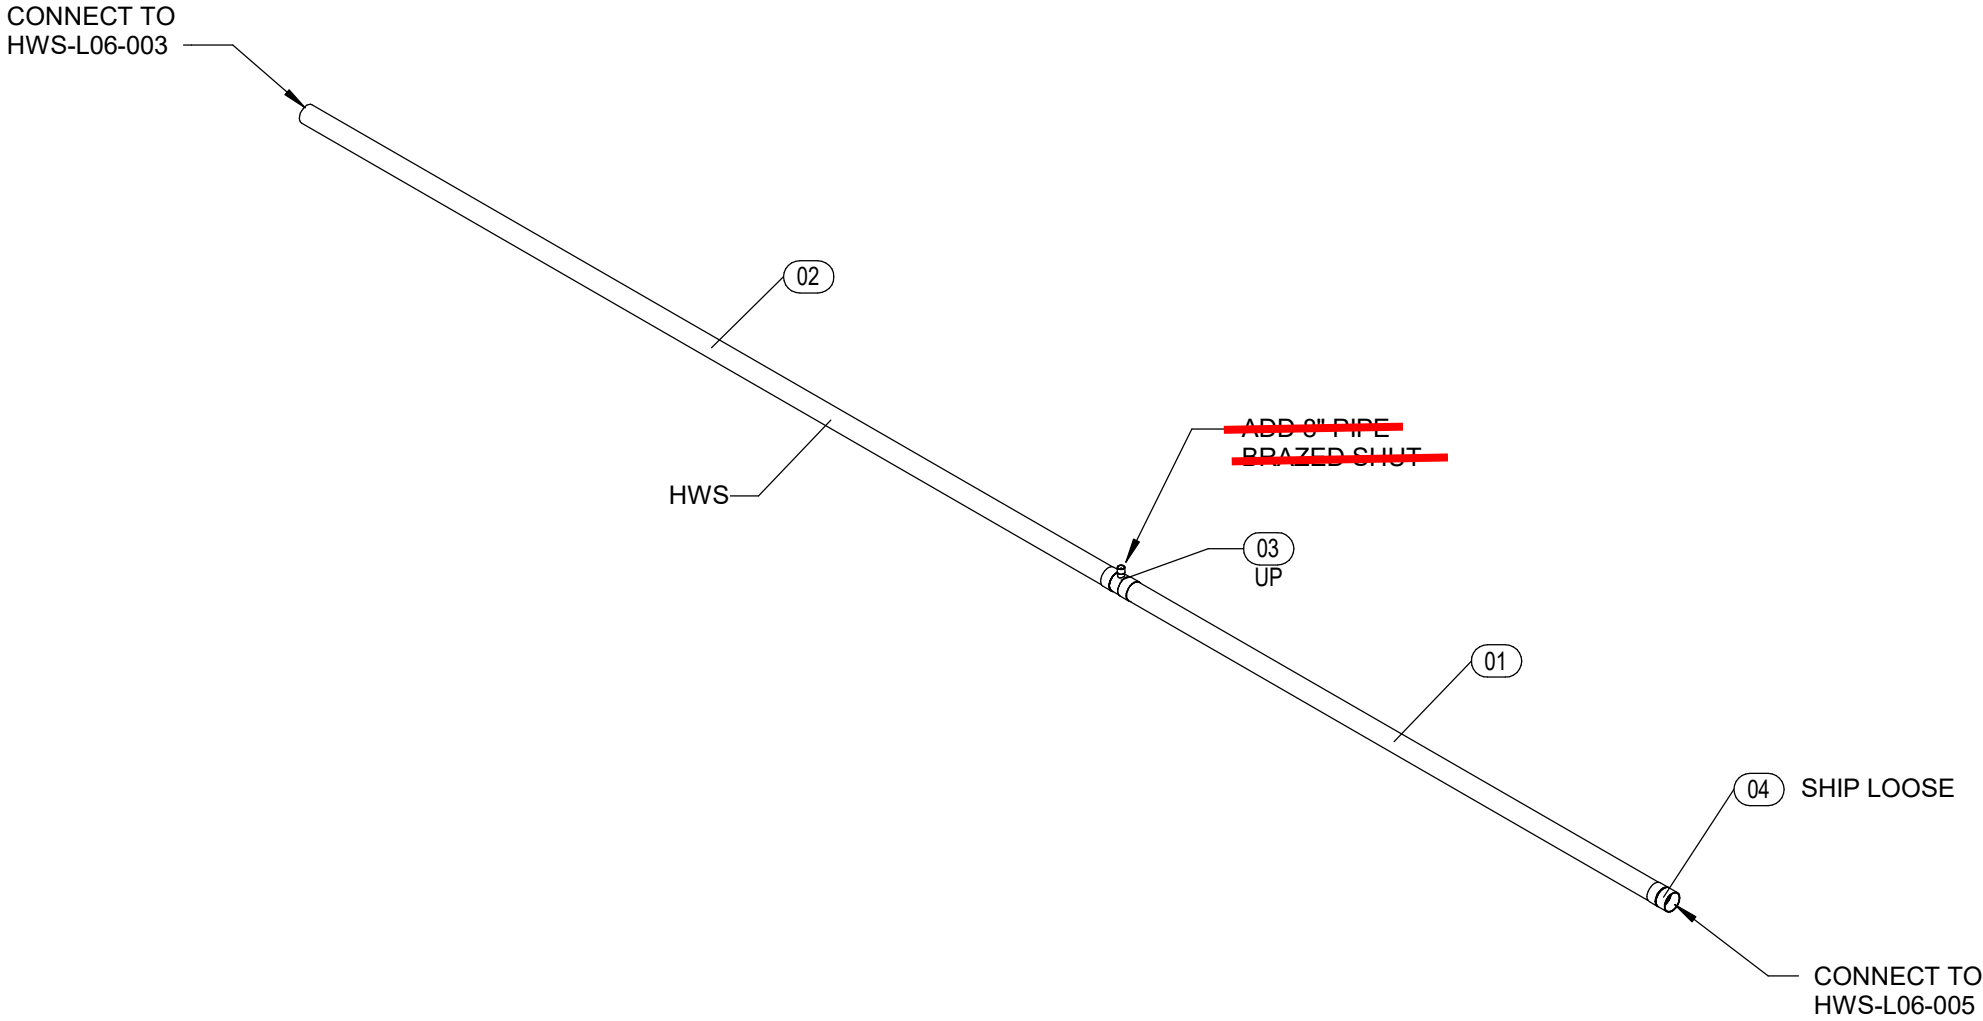

1 ISOMETRIC

SCALE:

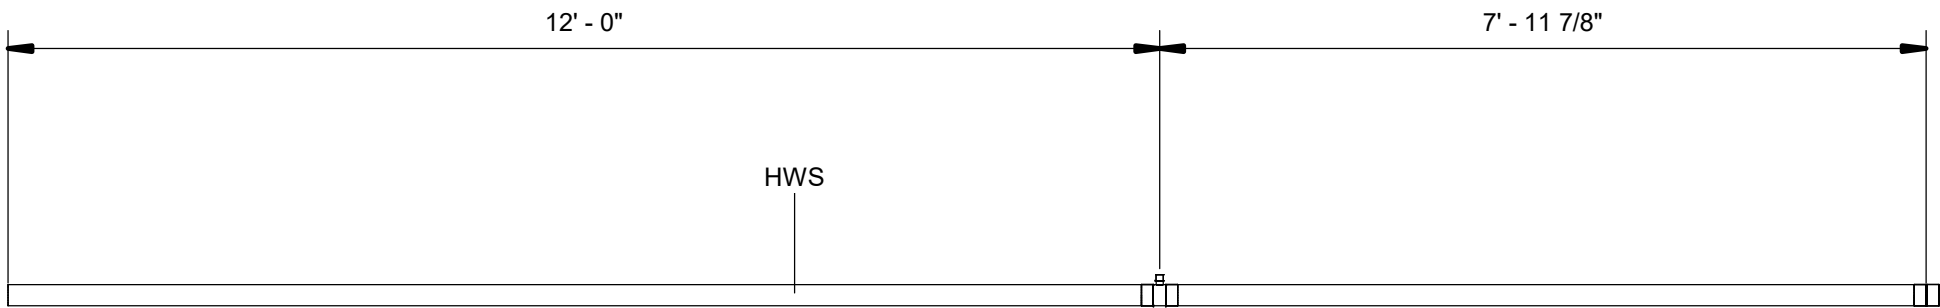


2 FRONT VIEW

SCALE: 1/2" = 1'-0"

A1	A3	B1	B3
A2	A4	B2	B4

JOB: WASH U NRB  
TICKET: HWS-L06-004  
Drawn By: Author  
DATE: 10/08/21  
DATE REQ:

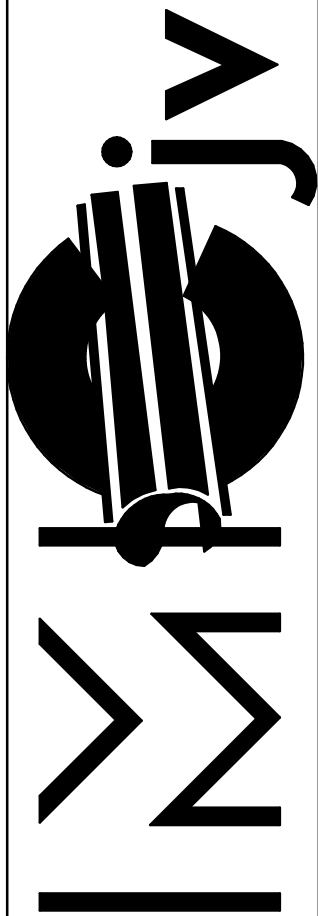

1233 N. Price Rd.  
St. Louis, Mo 63132-2303  
314-997-6600 phone