



BIM 360/WUSM NRBWUSM\_RB\_SPOOLING MASTER.rvt  
11/1/2021 10:21:44 AM

CUT AND PACKAGE ONLY  
DO NOT ASSEMBLE

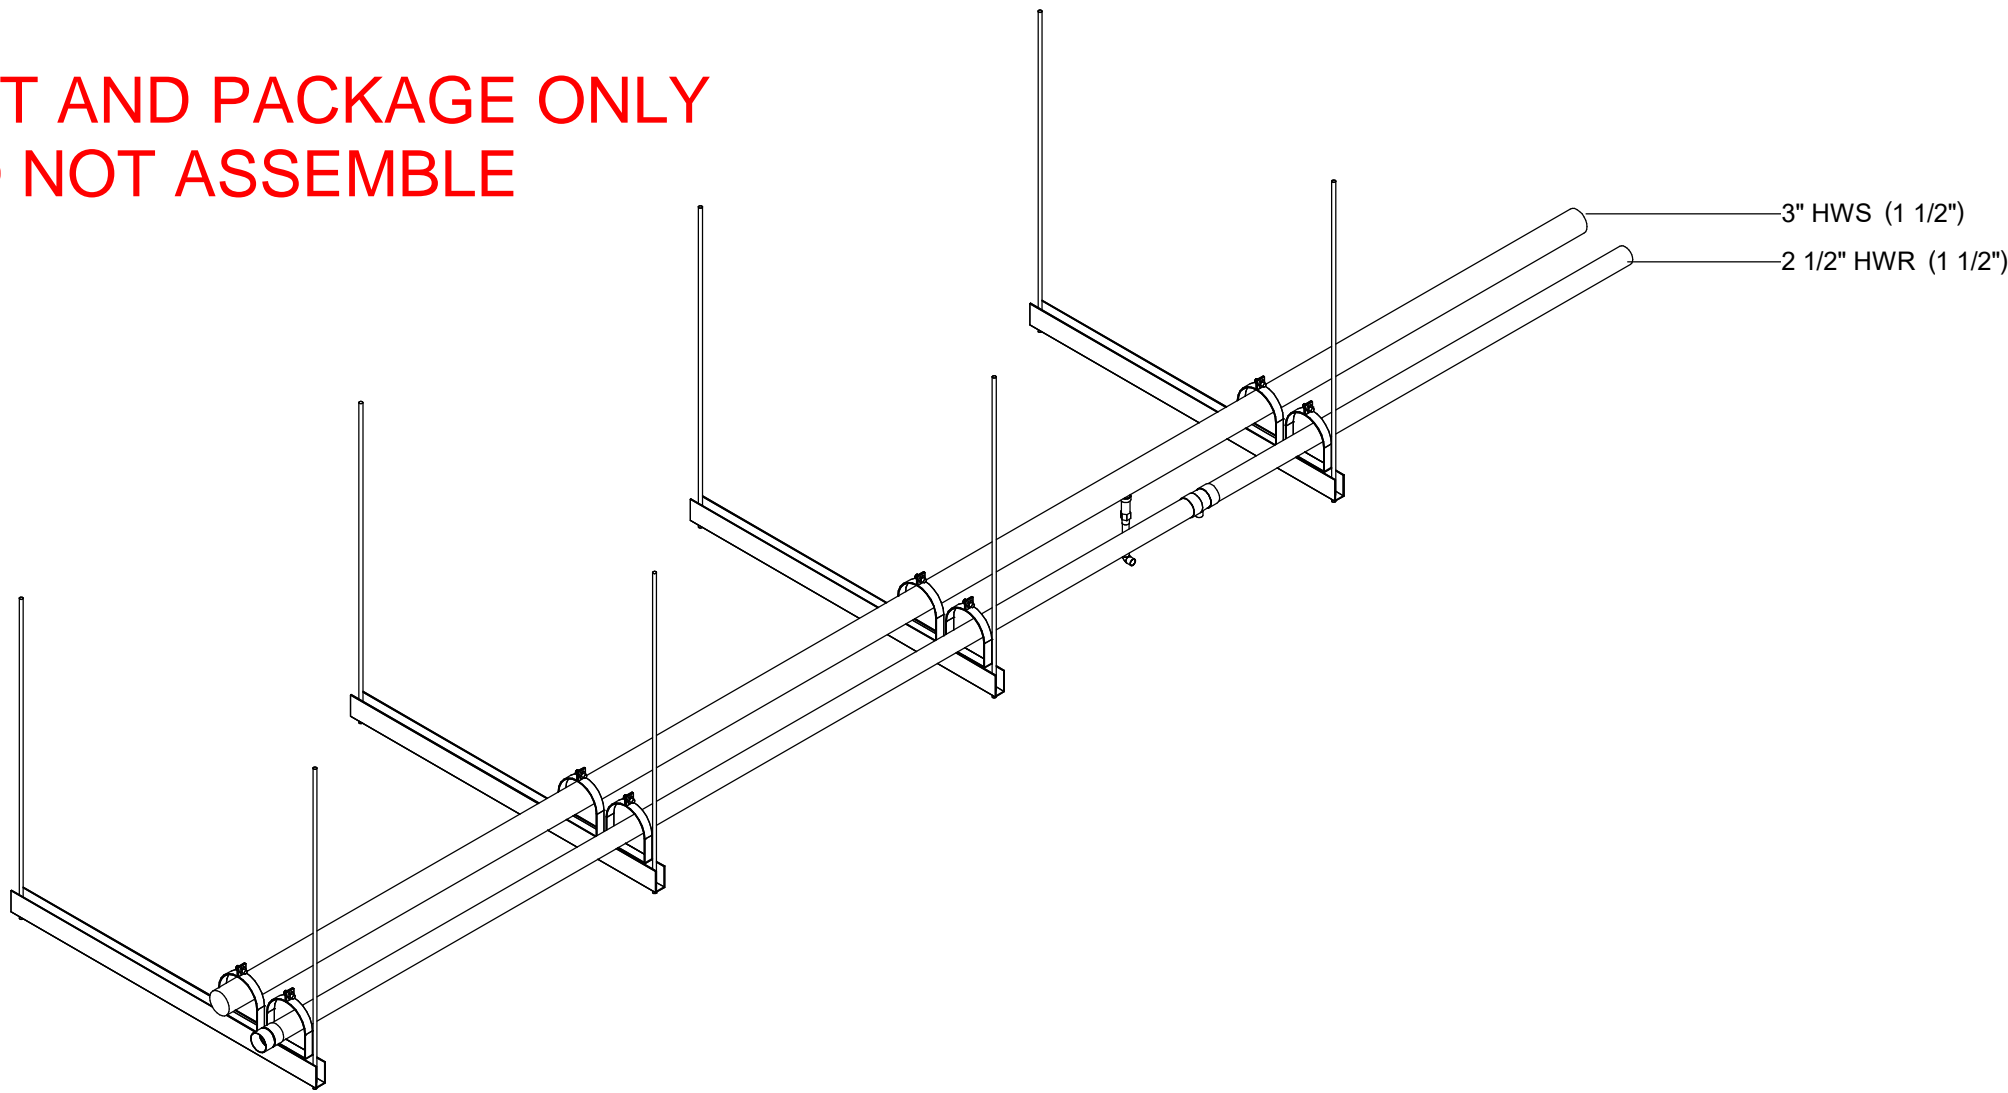


1 AS-L06-066 - ISOMETRIC  
SCALE:

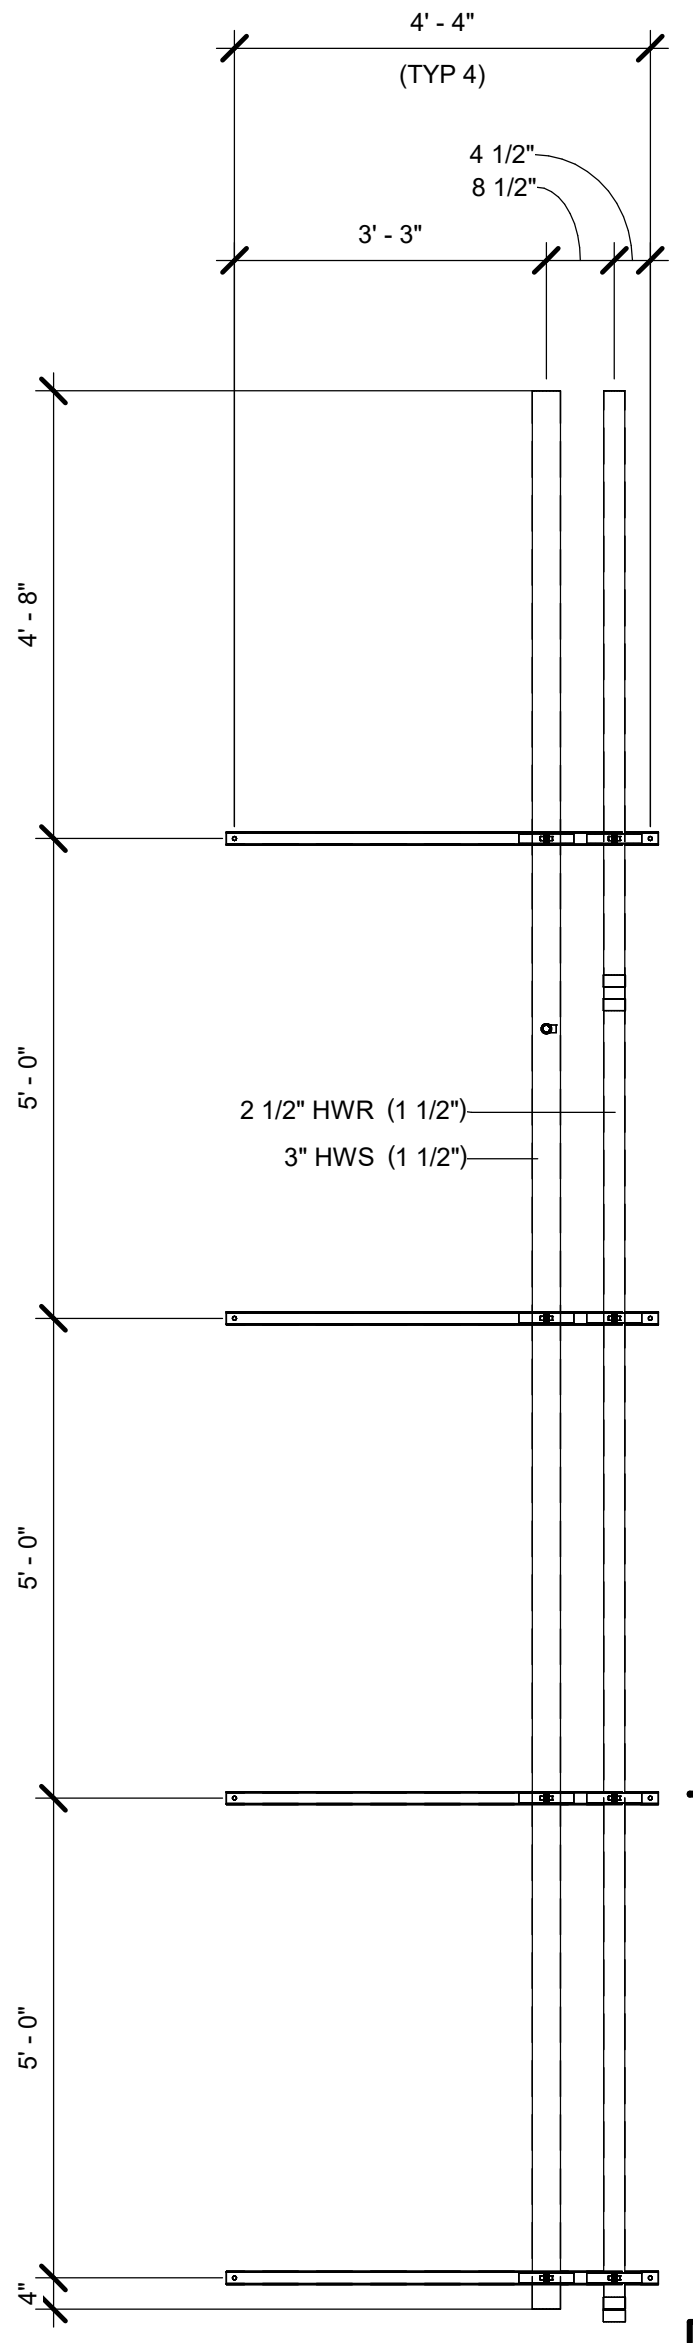

2 AS-L06-066  
SCALE: 1/2" = 1'-0"

A1	A3	B1	B3
A2	A4	B2	B4


JOB: WASH U NRB  
TICKET: AS-L06-066  
Drawn By: Author  
DATE: 11/01/21  
DATE REQ:

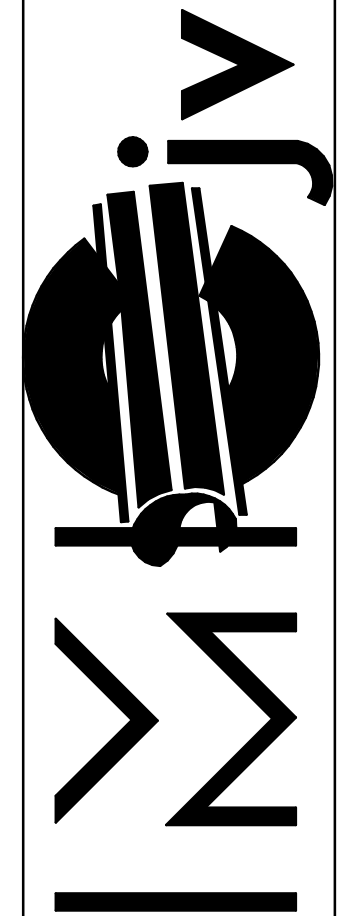


1233 N. Price Rd.  
St. Louis, Mo 63132-2303  
314-997-6600 phone

BIM 360://WUSM NRBWUSM\_RB\_HPF.rvt  
10/18/2021 4:08:17 PM


Mark	Qty	Size	Description	Length	Strut Width	Rob 1	Rob 2	Insulation
<del>01</del>	<del>8</del>	<del>6"</del>	<del>B-Line B2000 ZN-Gal. 10 Pipe Clamp</del>					
02	4	50"	B-Line 1-5/8 GRN 12GA Bk/Bk 2in Slotted Unistrut		4' - 6"	4' - 0 5/8"	4' - 0 5/8"	
01	4	6 5/8"	B-LINE #2020					
03	4	5 5/8"	B-LINE #2066					

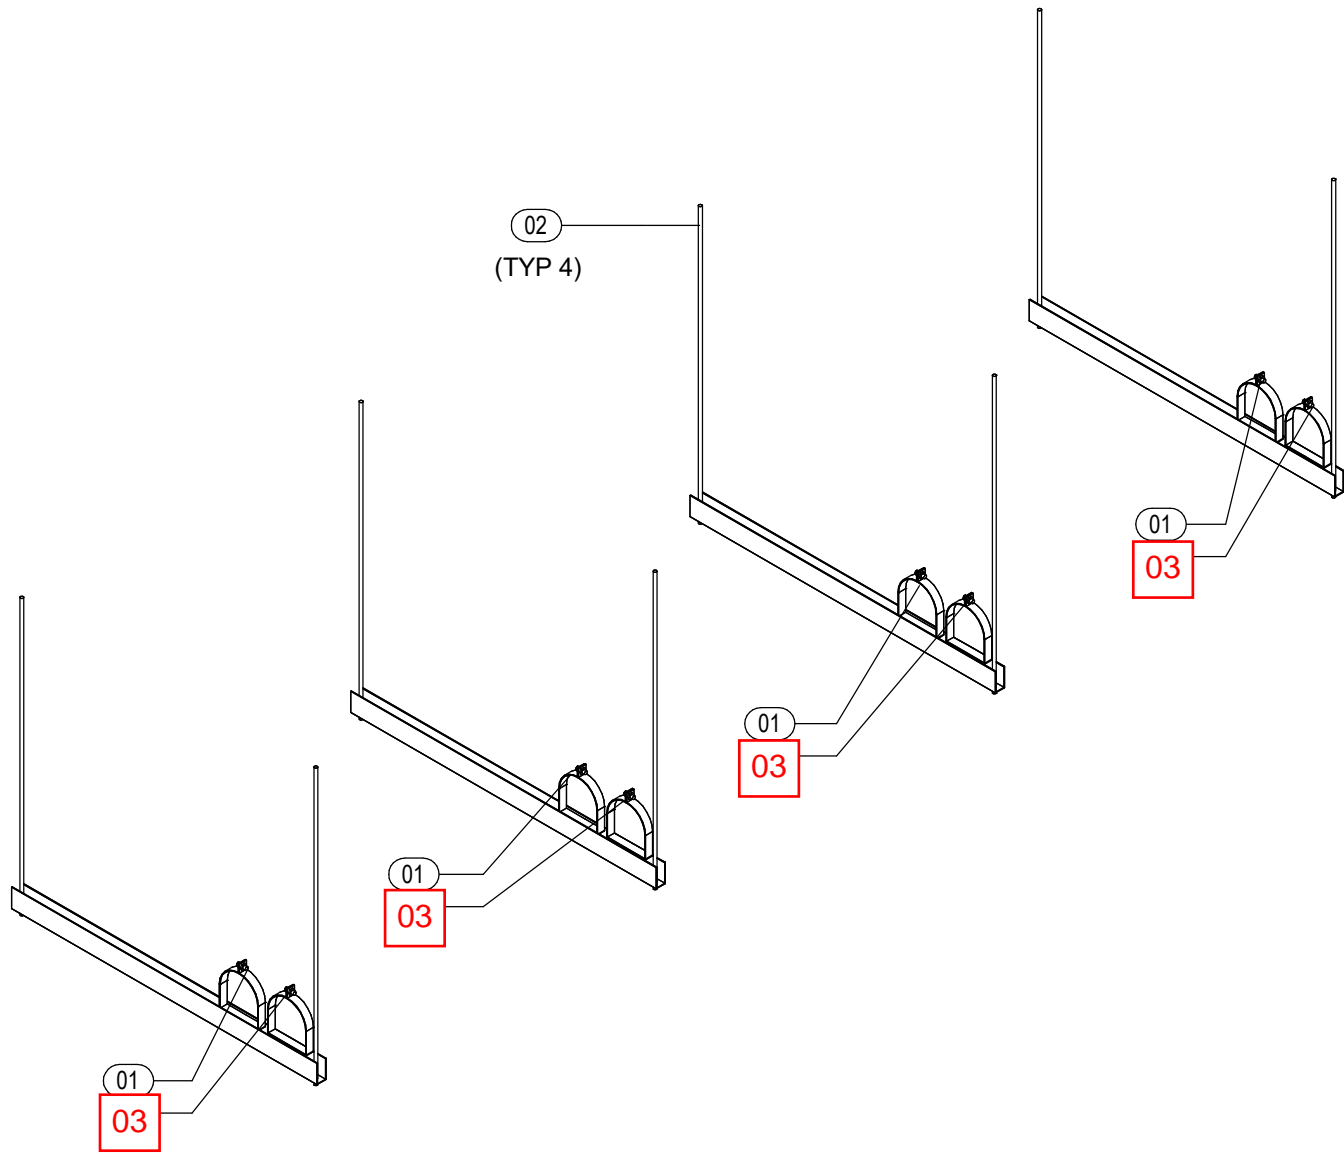

1 ISOMETRIC  
SCALE:

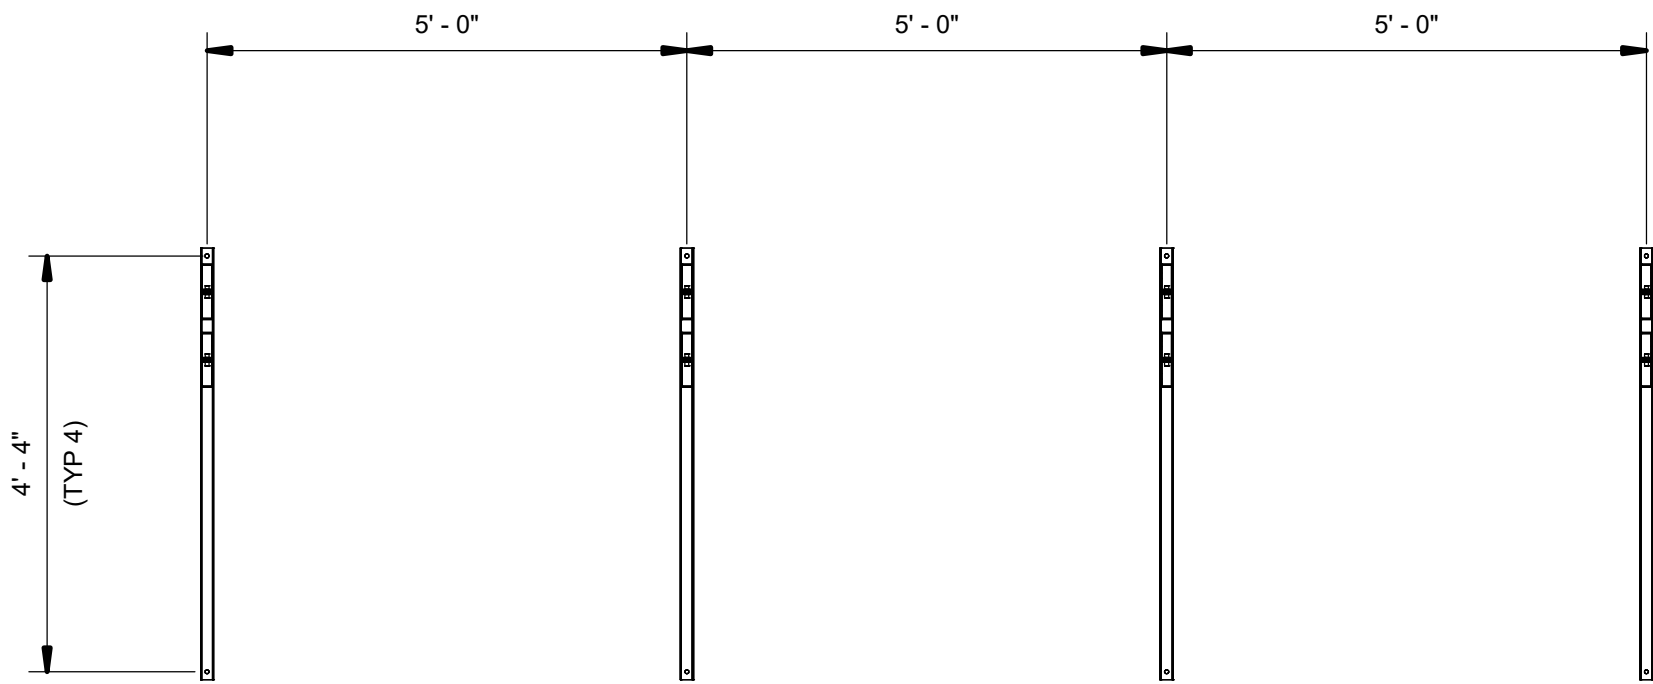


2 TOP VIEW  
SCALE: 1/2" = 1'-0"

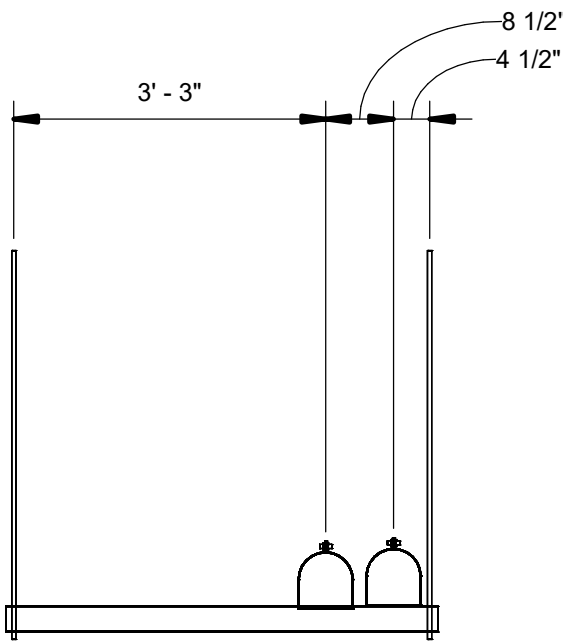

3 FRONT ELEVATION  
SCALE: 1/2" = 1'-0"

A1	A3	B1	B3
A2	A4	B2	B4


JOB:	WASH U NRB
TICKET:	HPHGR-L06-066
Drawn By: Author	
DATE: 10/11/21	DATE REQ:

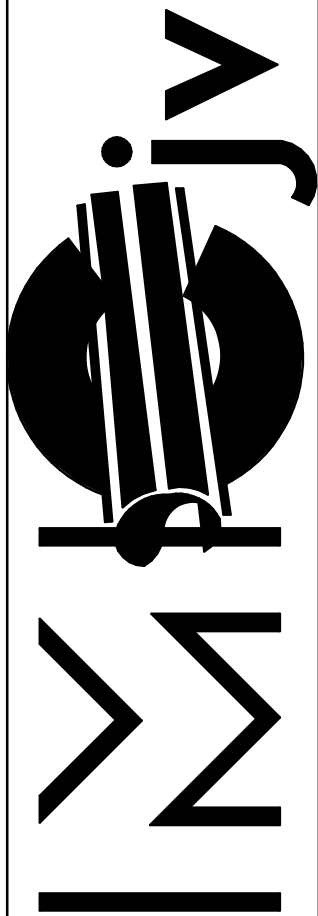


1233 N. Price Rd.  
St. Louis, Mo 63132-2303  
314-997-6600 phone

BIM 360://WUSM NRBWUSM\_RB\_HPF.rvt  
11/11/2021 4:39:20 PM

Mark	Qty	Size	Description	Length	Strut Width	Rob 1	Rob 2	Insulation
01	1	2 1/2"	Cerro Type K Hard Copper Pipe	6'-2 1/2"				1 1/2"
02	1	2 1/2"	Cerro Type K Hard Copper Pipe	13'-7 13/16"				1 1/2"
03	1	2 1/2"x3/4"x2 1/2"	Nibco Wrot 611R CxCxC Reducing Tee					1 1/2"
04	1	2 1/2"	Nibco Wrot 600 Dimpled Stop Coupling CxC					1 1/2"
05	1	3/4"	Generic Solder Joint					1"
06	2	2 1/2"	Generic Solder Joint					1 1/2"

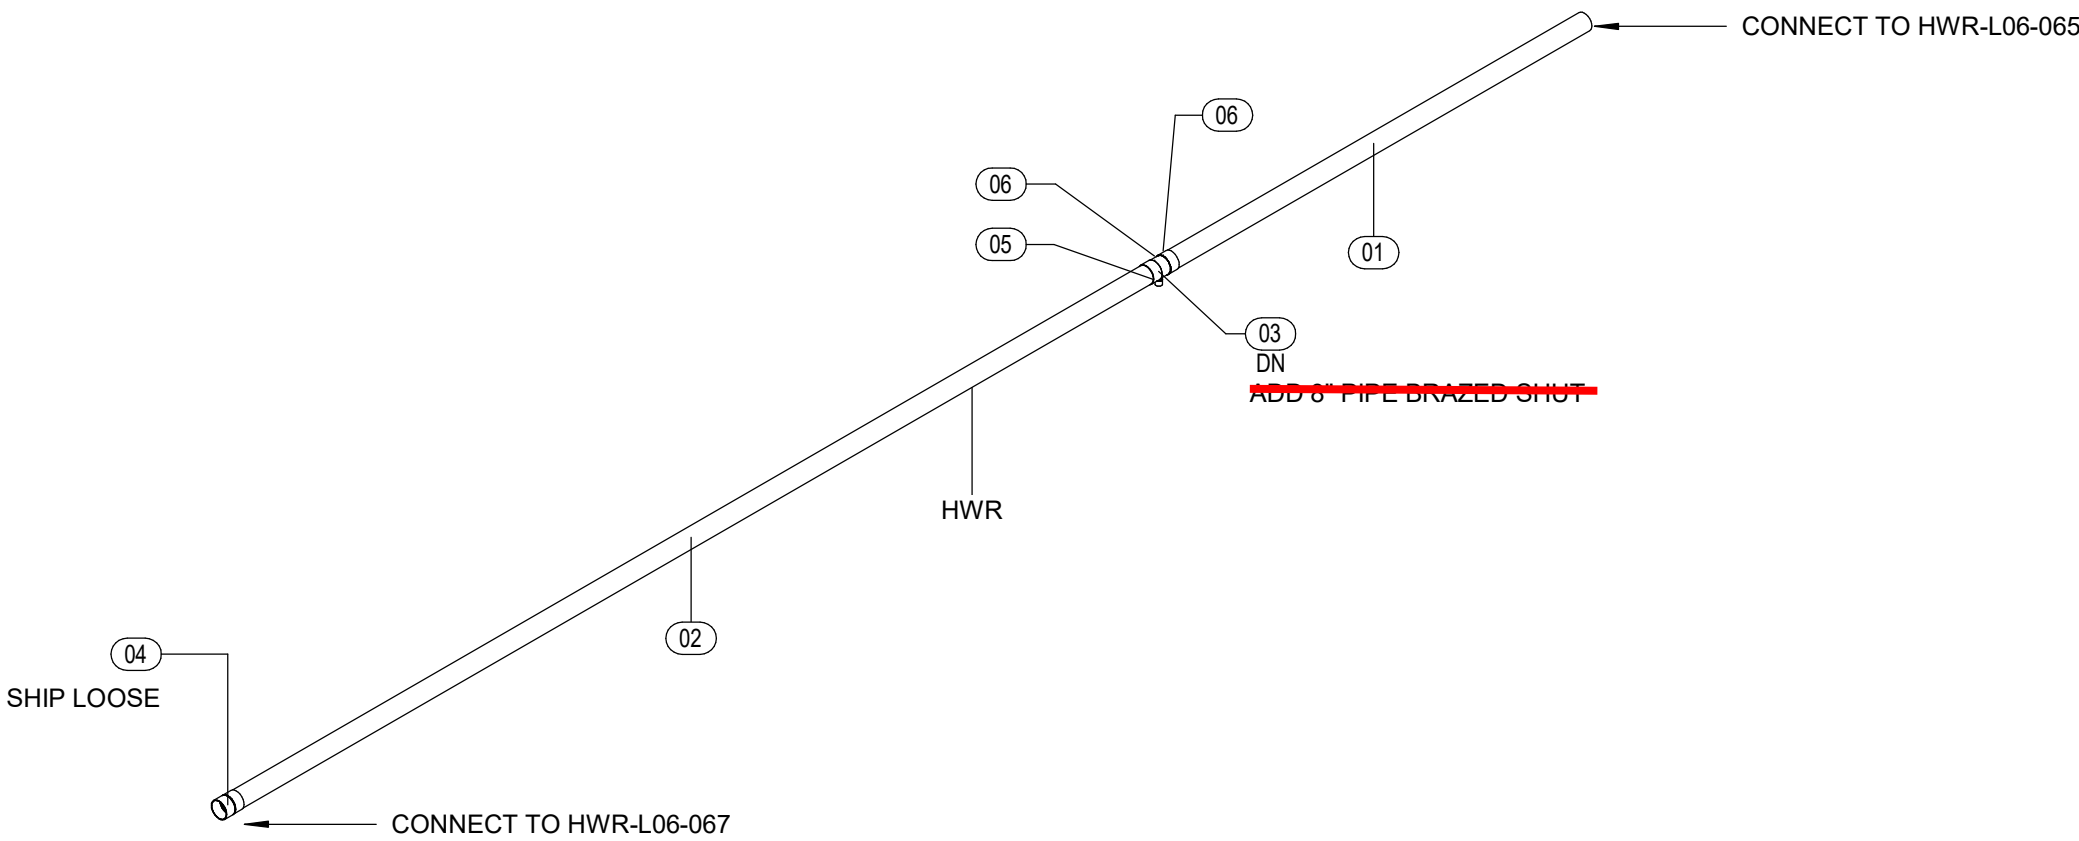


1 ISOMETRIC  
SCALE:

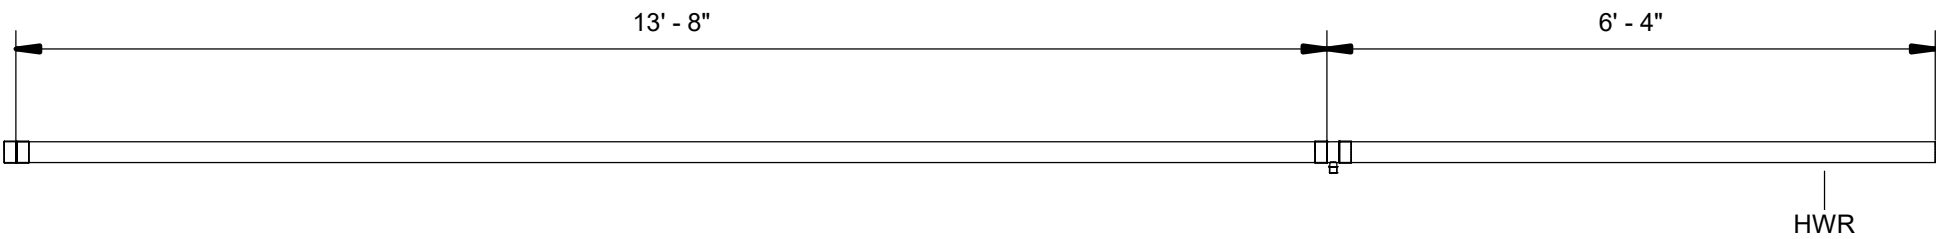

2 LEFT ELEVATION  
SCALE: 1/2\"/>

A1	A3	B1	B3
A2	A4	B2	B4


JOB:	WASH U NRB
TICKET:	HWR-L06-066
Drawn By: Author	
DATE: 10/28/21	DATE REQ:

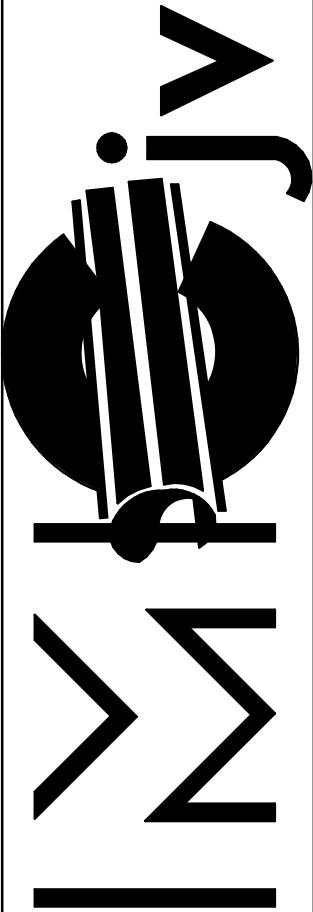

1233 N. Price Rd.  
St. Louis, Mo 63132-2303  
314-997-6600 phone


BIM 360://WUSM NRBWUSM\_RB\_HPF.rvt  
22-10-2021 16:48:54

Mark	Qty	Size	Description	Length	Strut Width	Rob 1	Rob 2	Insulation
<del>01</del>	<del>1</del>	<del>3/4"</del>	<del>Cerro Type K Hard Copper Pipe</del>	<del>8'-3 1/16"</del>				1"
02	1	3"	Chicago Area Sch 40 SA-53B CS ERW Pipe PE	19'-11 7/8"				1 1/2"
03	1	3/4"	Victaulic No.647 TT Dielectric Transition Fitting					1"
<del>04</del>	<del>1</del>	<del>3/4"</del>	<del>Nibco Wrot 607-00 Deg Ell CwC</del>					1"
<del>05</del>	<del>1</del>	<del>3/4"</del>	<del>Nibco Wrot 608 Adapter OxF</del>					1"
06	1	3"x3/4"	Anvil 3000# FS Thread-O-Let					1"

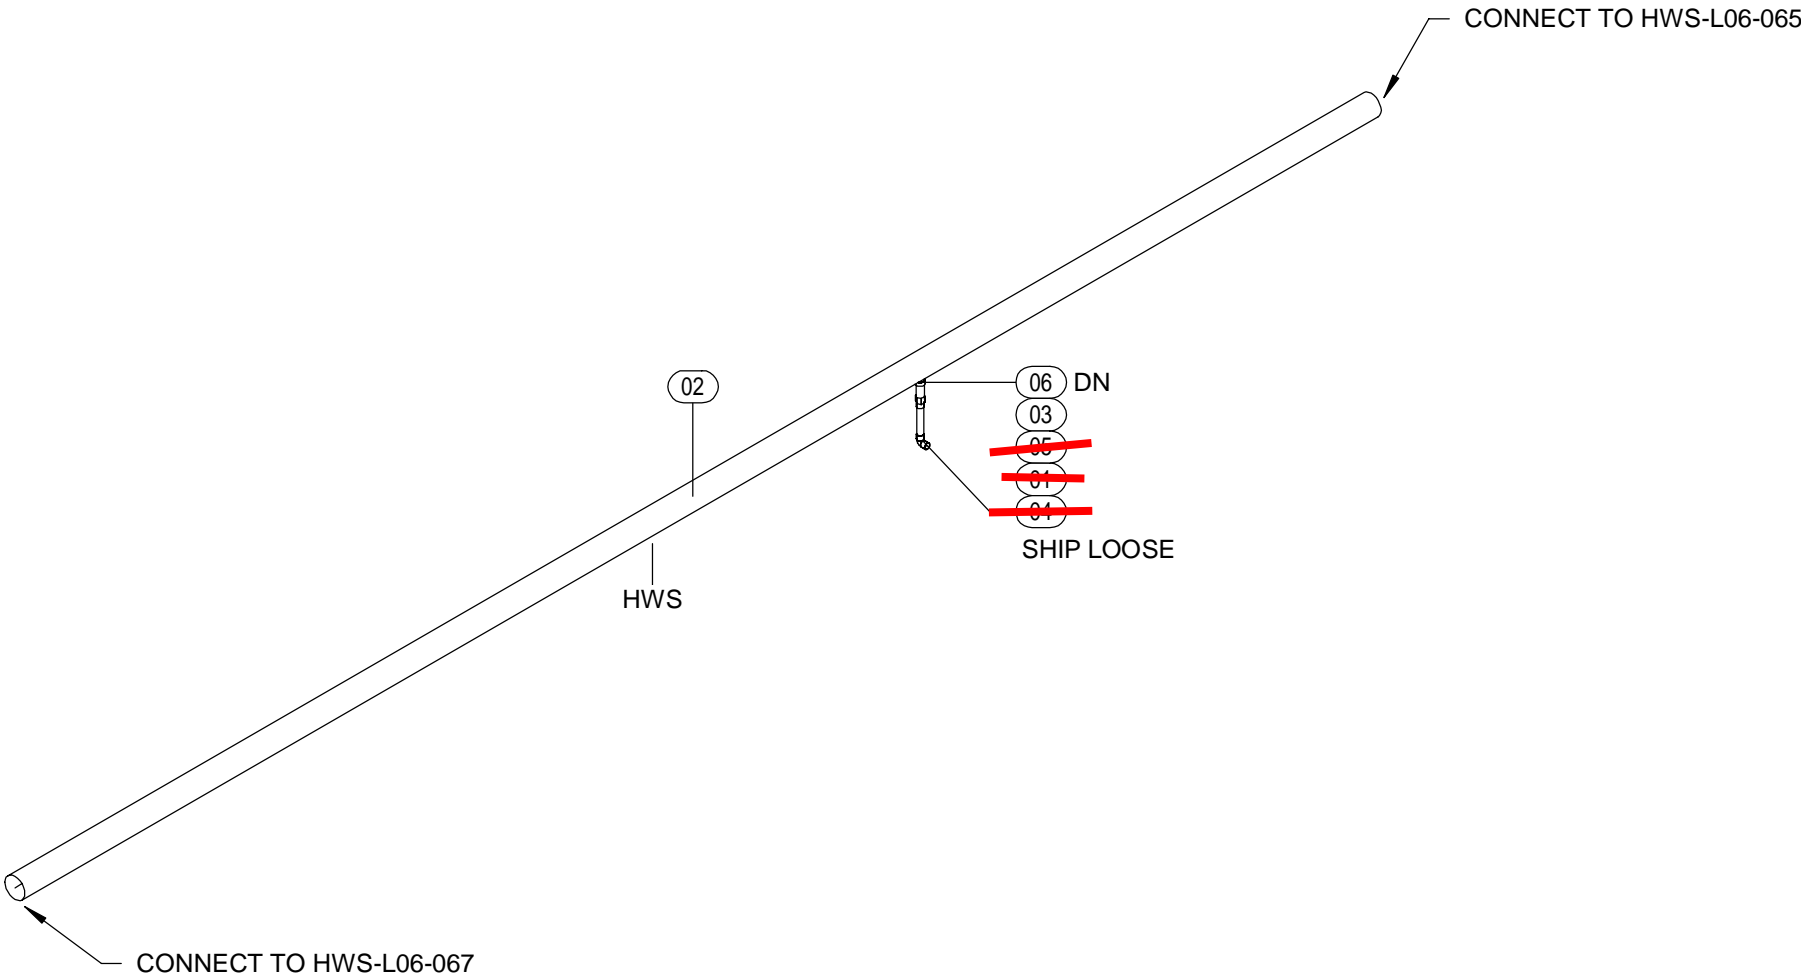

1 ISOMETRIC

SCALE:

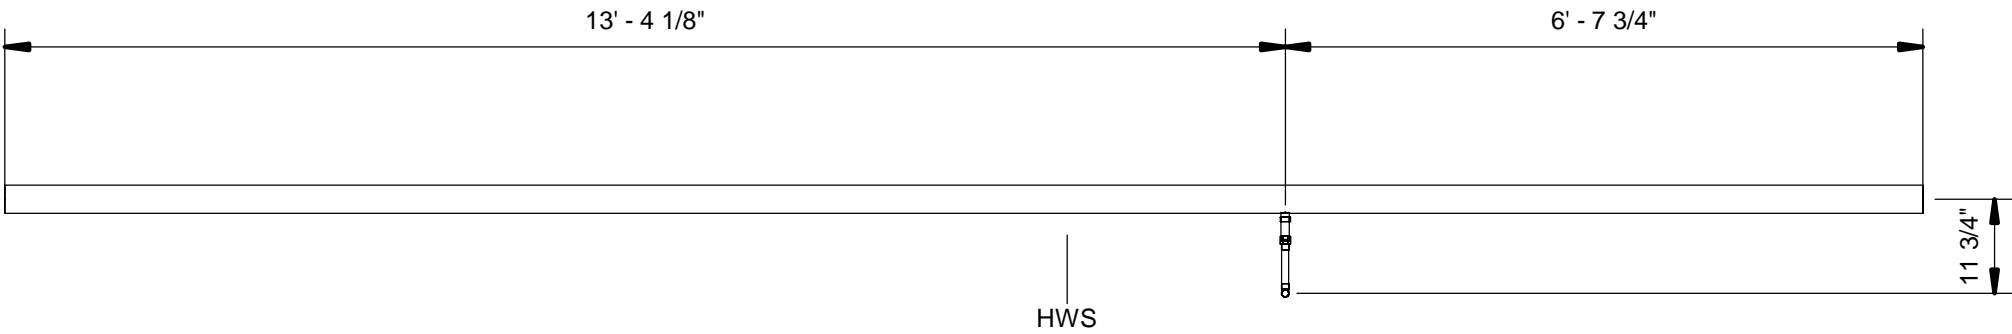


2 LEFT ELEVATION

SCALE: 1/2" = 1'-0"

A1	A3	B1	B3
A2	A4	B2	B4

JOB: WASH U NRB  
TICKET: HWS-L06-066  
Drawn By: Author  
DATE: 10/22/21  
DATE REQ:

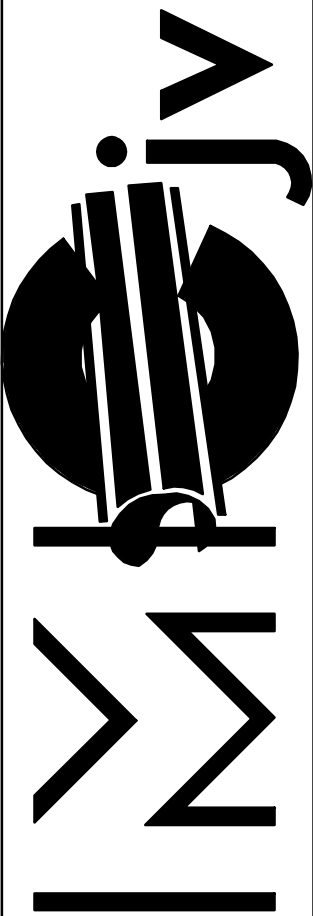

1233 N. Price Rd.  
St. Louis, Mo 63132-2303  
314-997-6600 phone